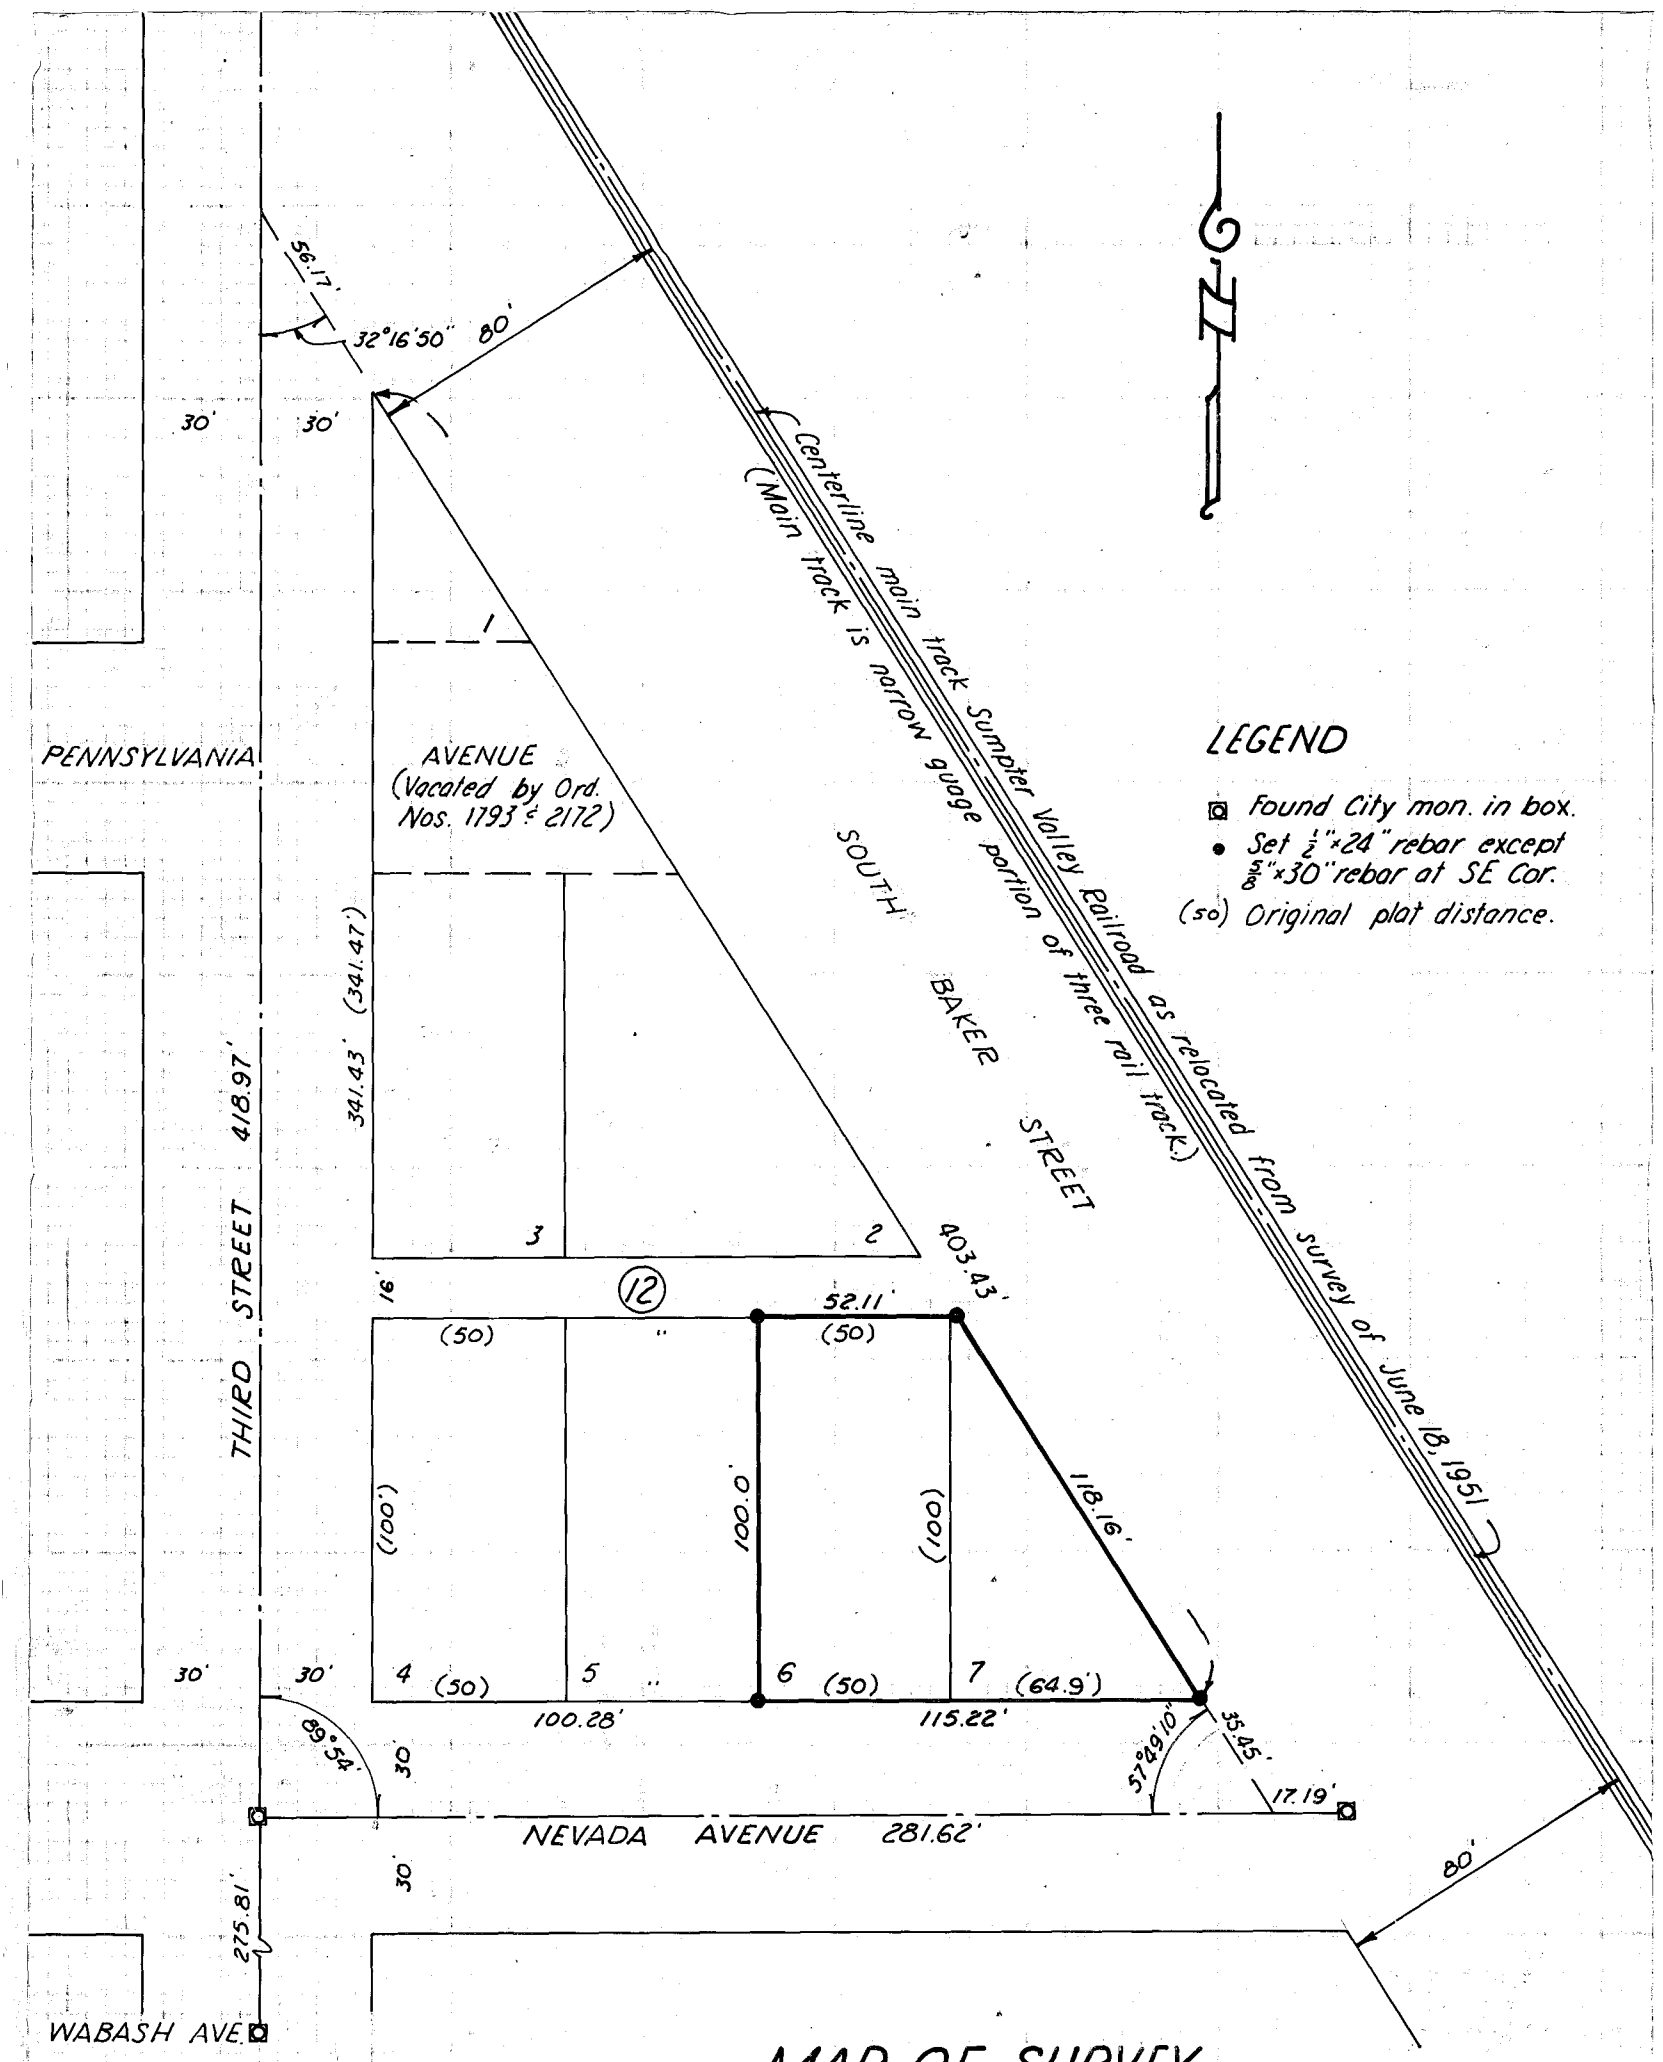

MAP OF SURVEY

LOTS 6 & 7, BLOCK 12, JACKSON'S ADD'N TO BAKER, OREGON

Feb. 14 & March 6, 1978 1"=50'

For Bob Hendriksen

REGISTERED PROFESSIONAL LAND SURVEYOR

James D. Hanley

OREGON
SEPTEMBER 23, 1977
JAMES D. HANLEY
1206

FILED March 28, 1978
BAKER COUNTY SURVEYOR
SURVEY NO. 9-40-120 BC