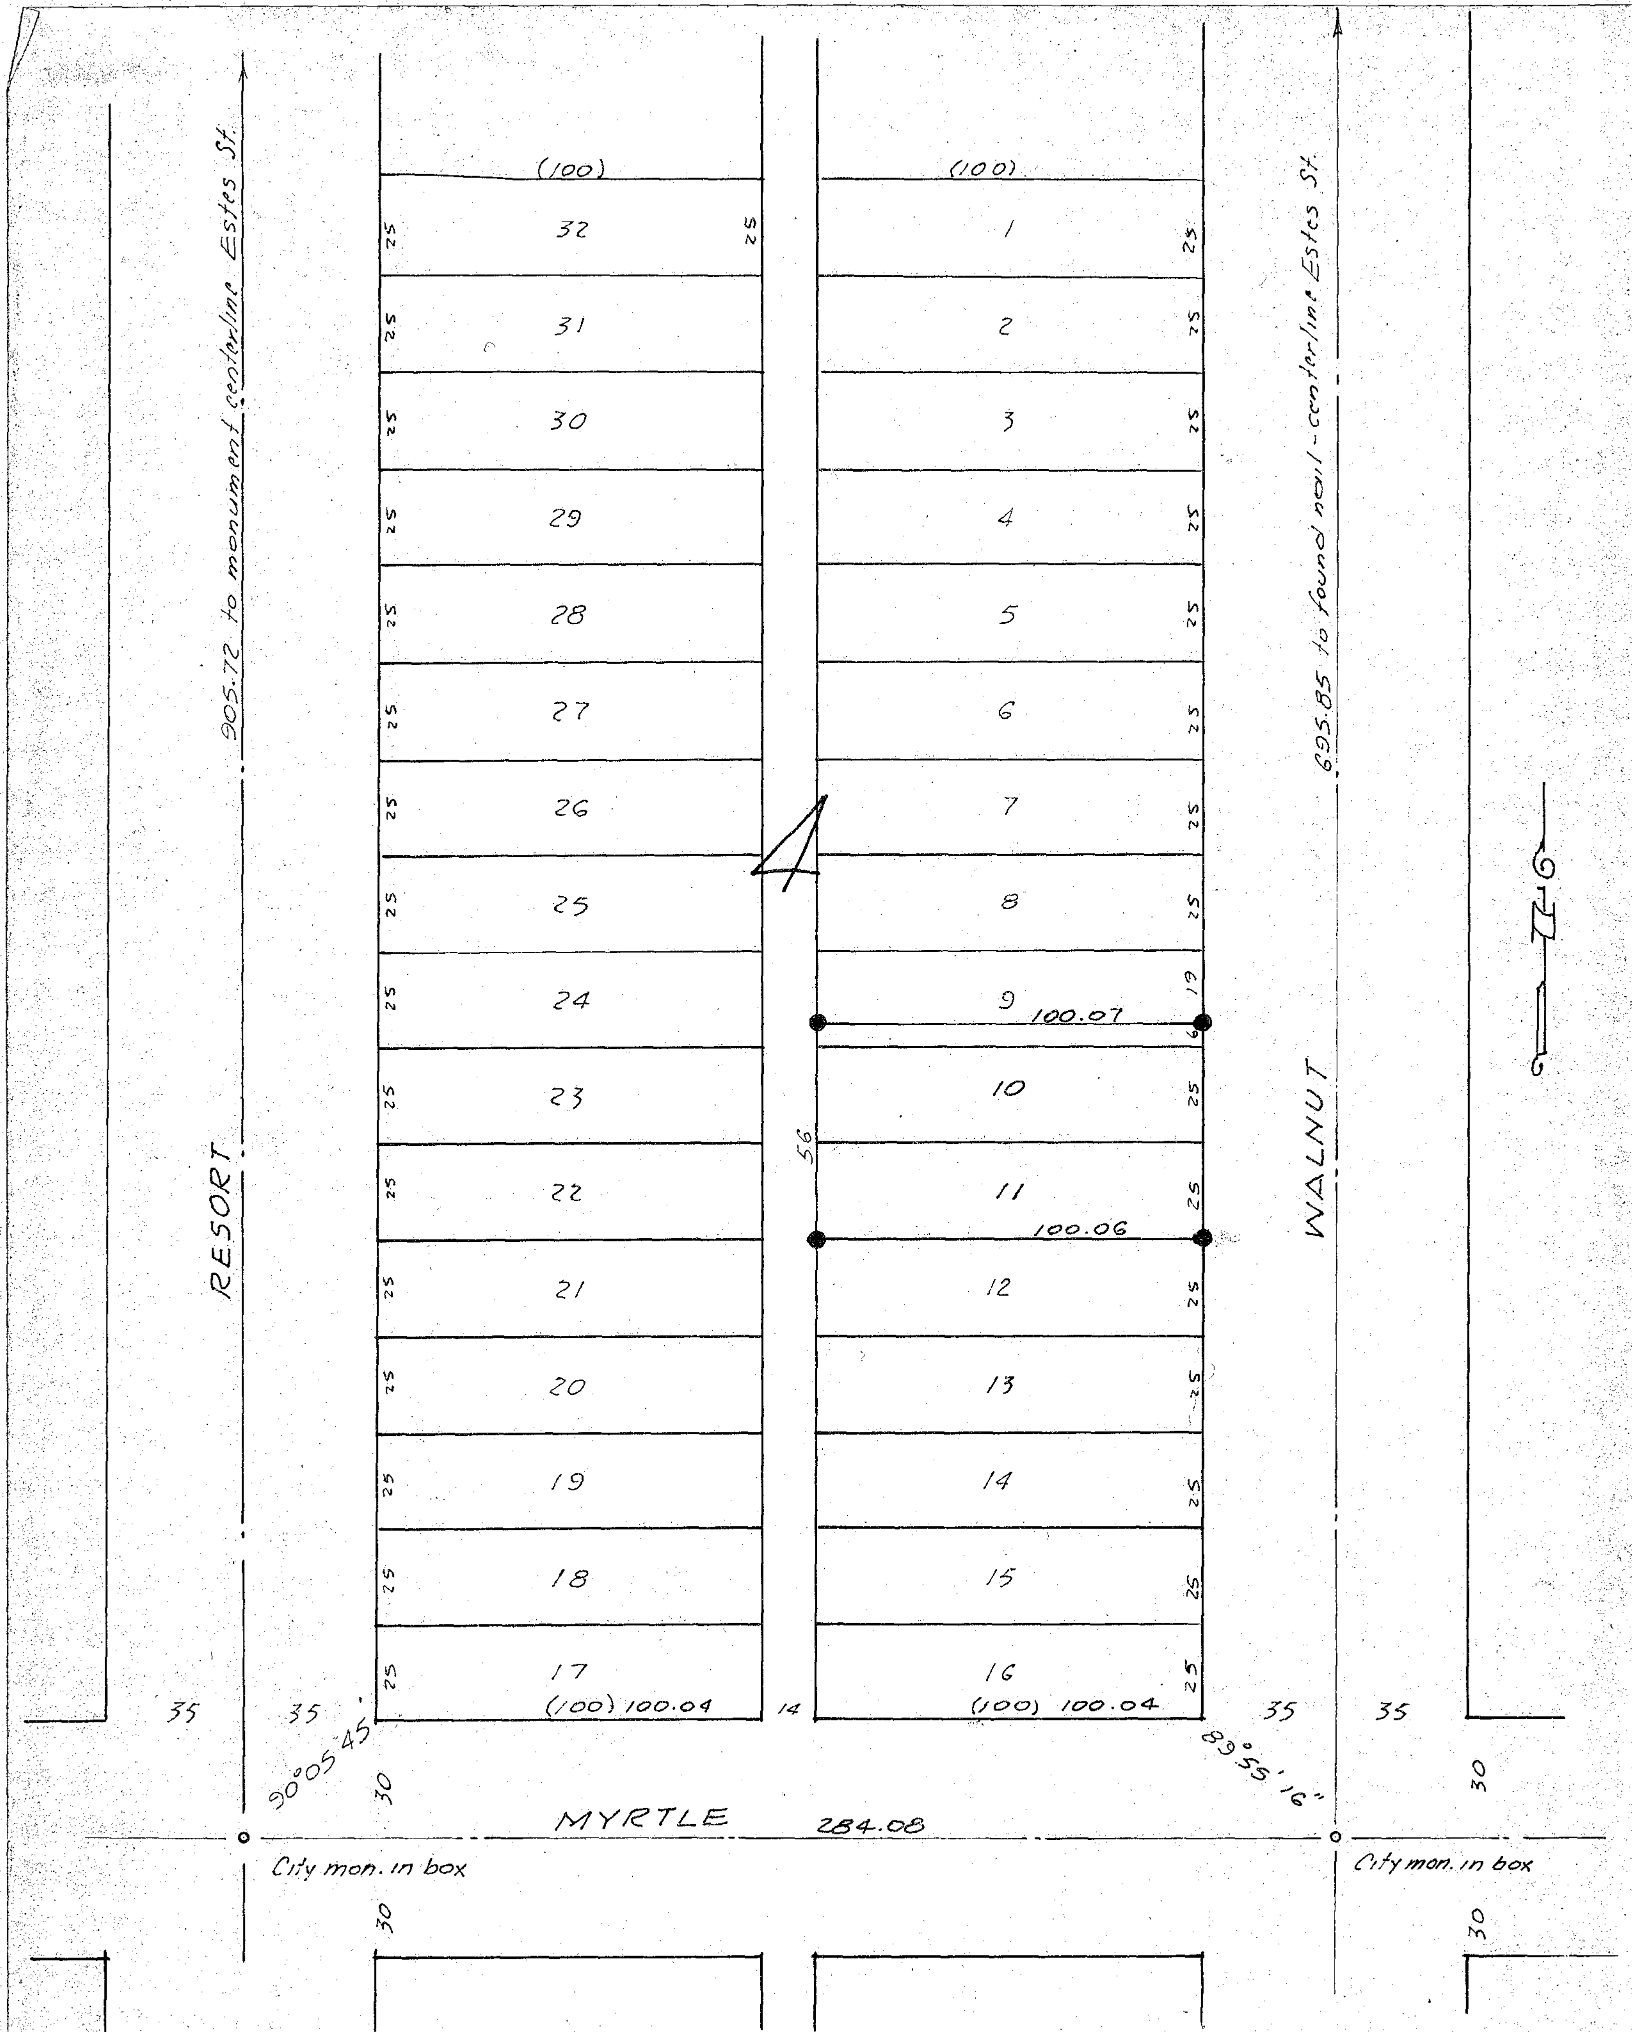

MAP OF SURVEY

LOTS 10 & 11 & South 6 ft. of LOT 9, BLOCK 4
WILOVALE ADDITION TO BAKER, OREGON
Scale 1" = 50' Jan. 15 & 16, 1979
For Richard Badgley

● LEGEND: Set ½" x 24" rebar

REGISTERED PROFESSIONAL LAND SURVEYOR

James D. Hanley

OREGON
SEPTEMBER 23, [illegible]
JAMES D. HANLEY
1206

FILED Feb. 1, 1979
BAKER COUNTY SURVEYOR
SURVEY NO. 9-40-132 BC