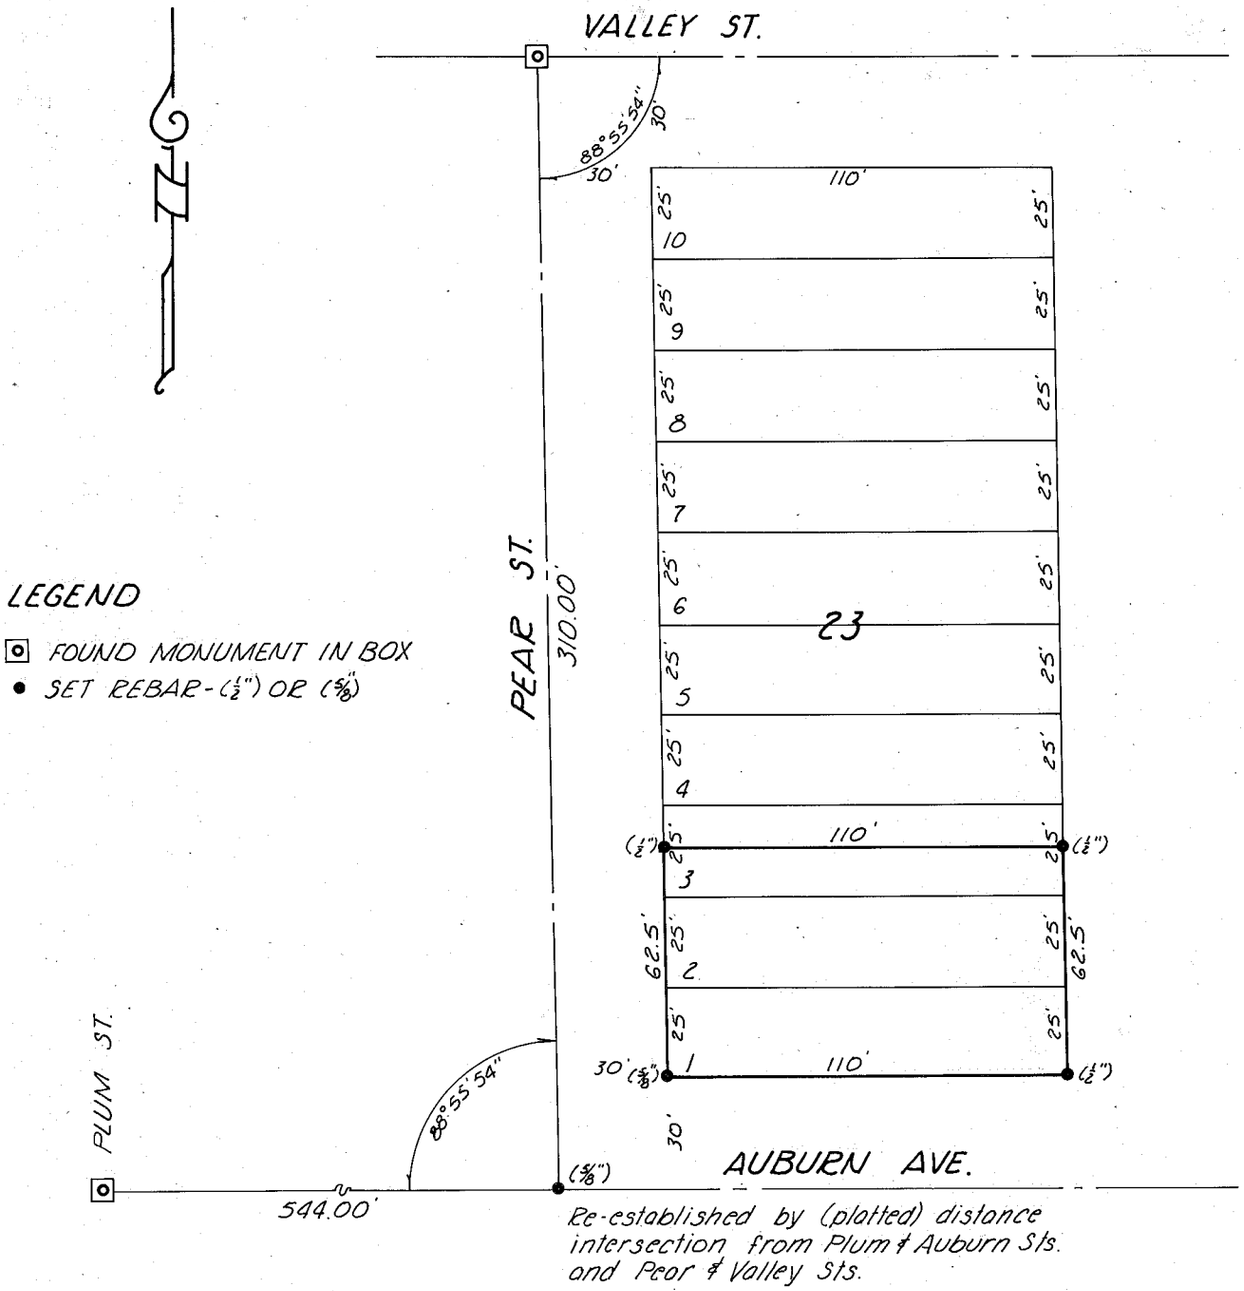

MAP OF SURVEY

IN BLOCK 23, PACIFIC ADDITION TO BAKER, OREGON

Surveyed March 9 & 12, 1979 Scale 1"=50'

For Tom Rudolph

REGISTERED PROFESSIONAL LAND SURVEYOR

James D. Hanley

OREGON
SEPTEMBER 23, 1977
JAMES D. HANLEY
1206

FILED March 30, 1979
BAKER COUNTY SURVEYOR
SURVEY NO. 9-40-141 A