


**BLOCK 17
MIX'S
ADDITION**

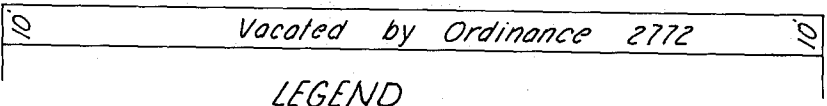

LEGEND

- Found 3/4" iron monument
- Set 5/8" rebar
- () Original Plat distance
- [] 1974 Resurvey distance

MAP OF SURVEY

Surveyed March 29, 1979 Scale 1"=50'
Glenn Densley

FILED April 2, 1979
BAKER COUNTY SURVEYOR
SURVEY NO. 9-10-142

**REGISTERED
PROFESSIONAL
LAND SURVEYOR**

William L. Hanley

**OREGON
JULY 14, 1978
WILLIAM L. HANLEY
1639**