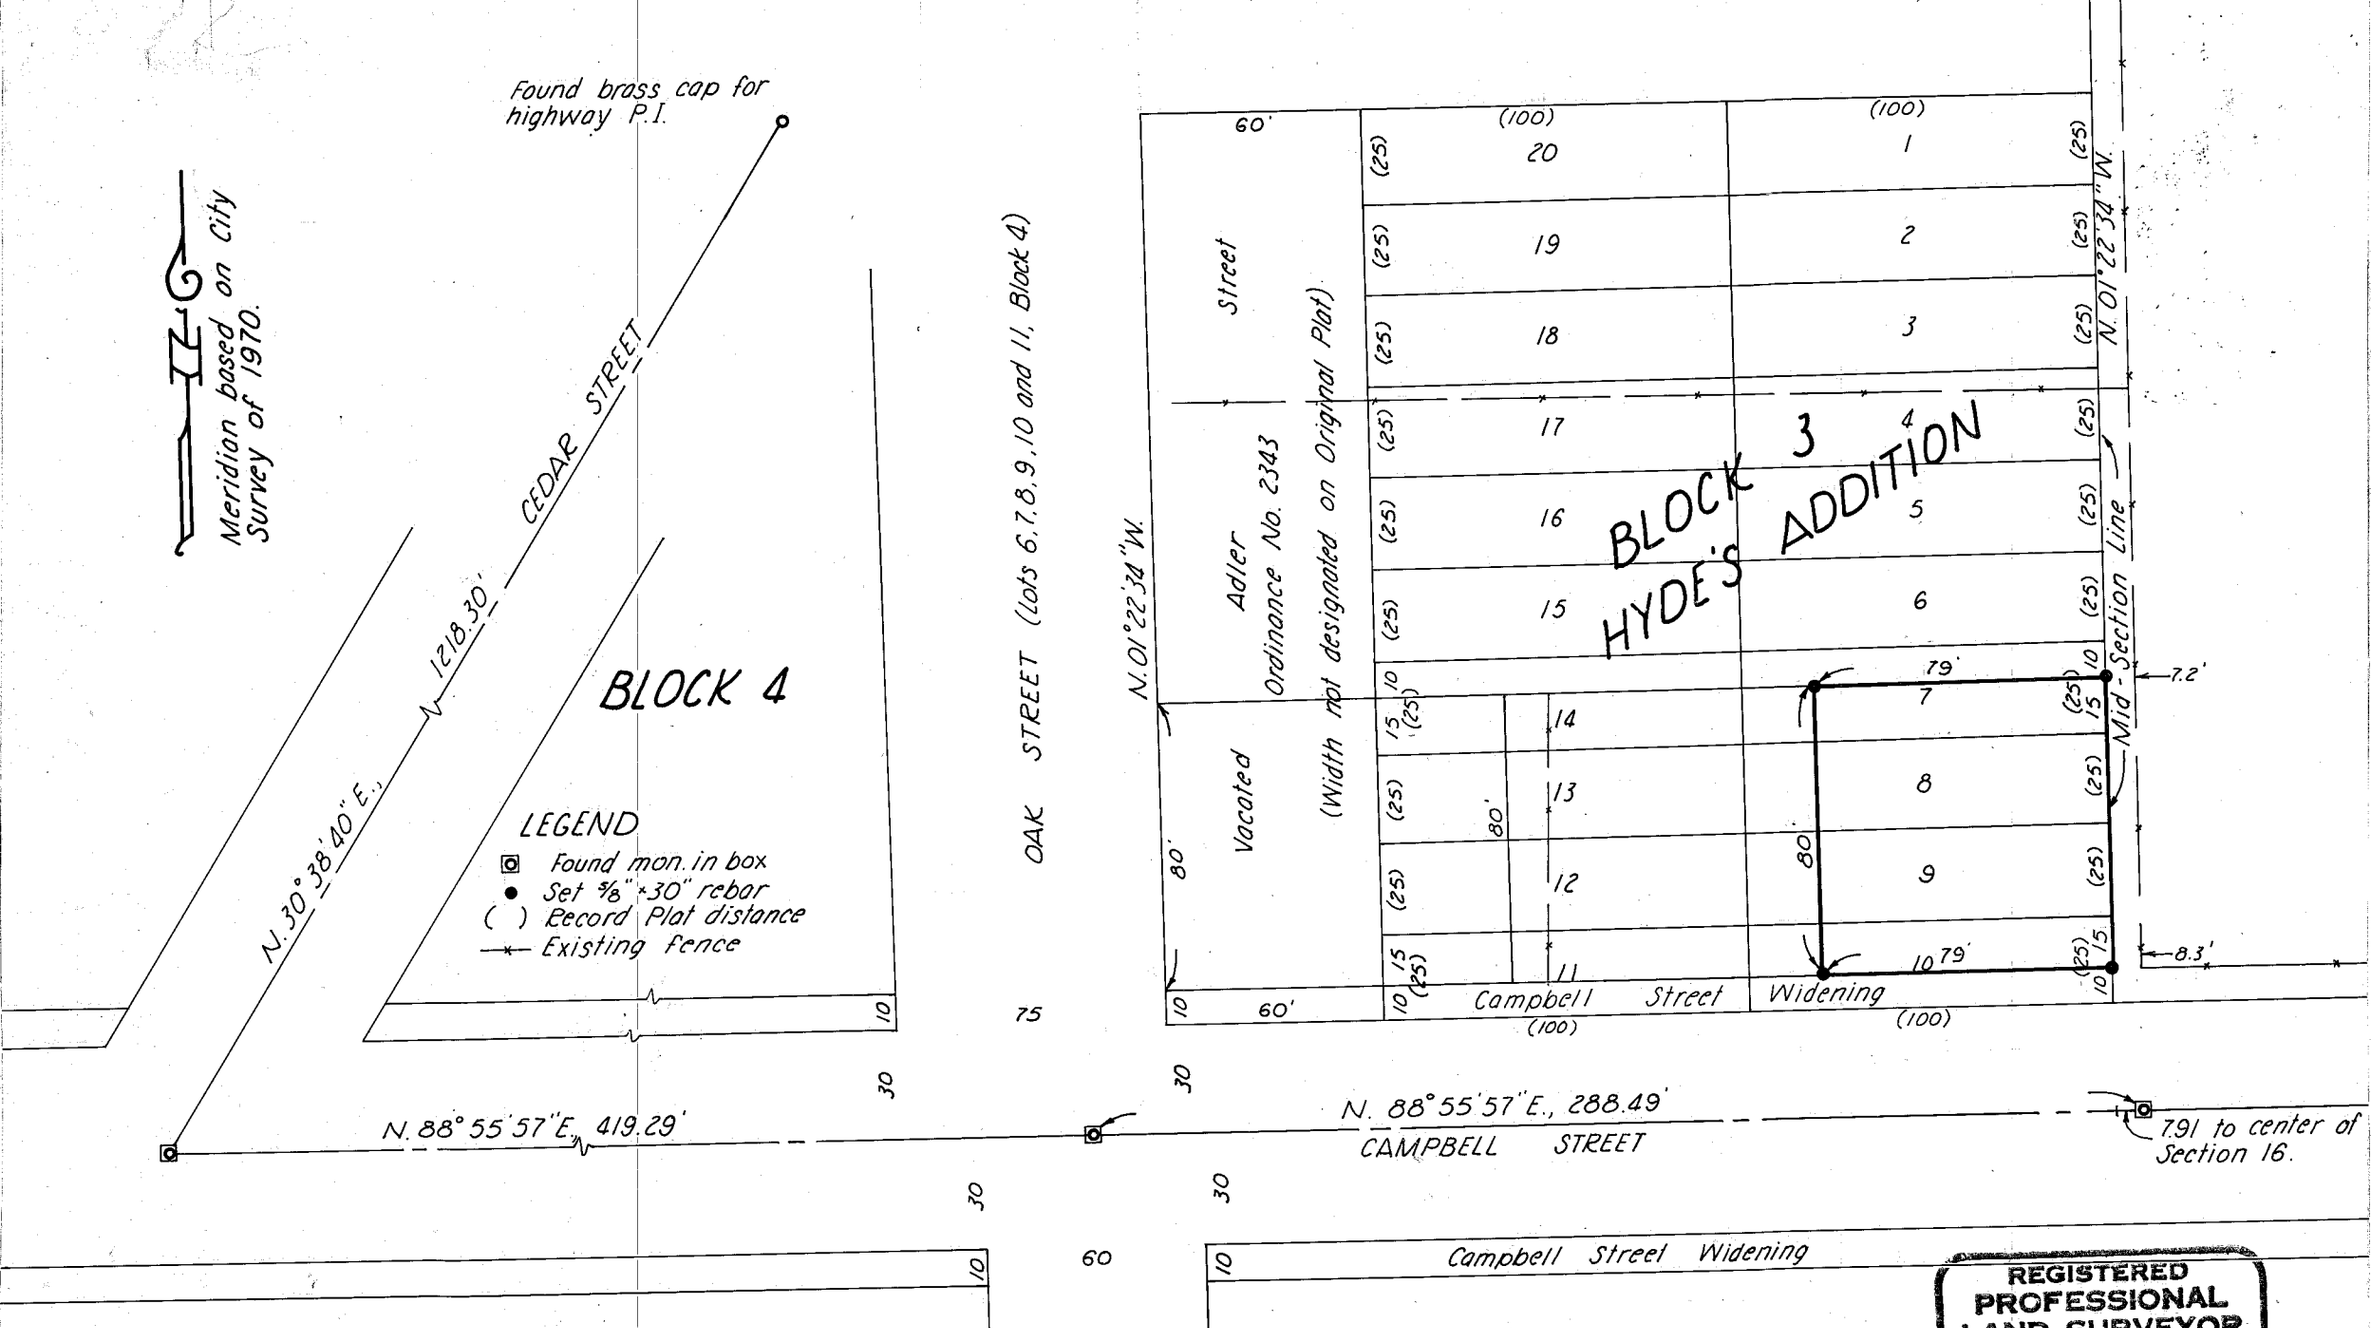

FILED April 3, 1979
BAKER COUNTY SURVEYOR
SURVEY NO. 9-40-146

MAP OF SURVEY

Surveyed Feb. 28, March 1 & 19, 1979 1"=50'

For C.P. Fagenstrom

REGISTERED PROFESSIONAL LAND SURVEYOR

James D. Hanley

OREGON
SEPTEMBER 23, 1977
JAMES D. HANLEY
1206