


Cor. to Secs. 8, 9, 16 & 17.

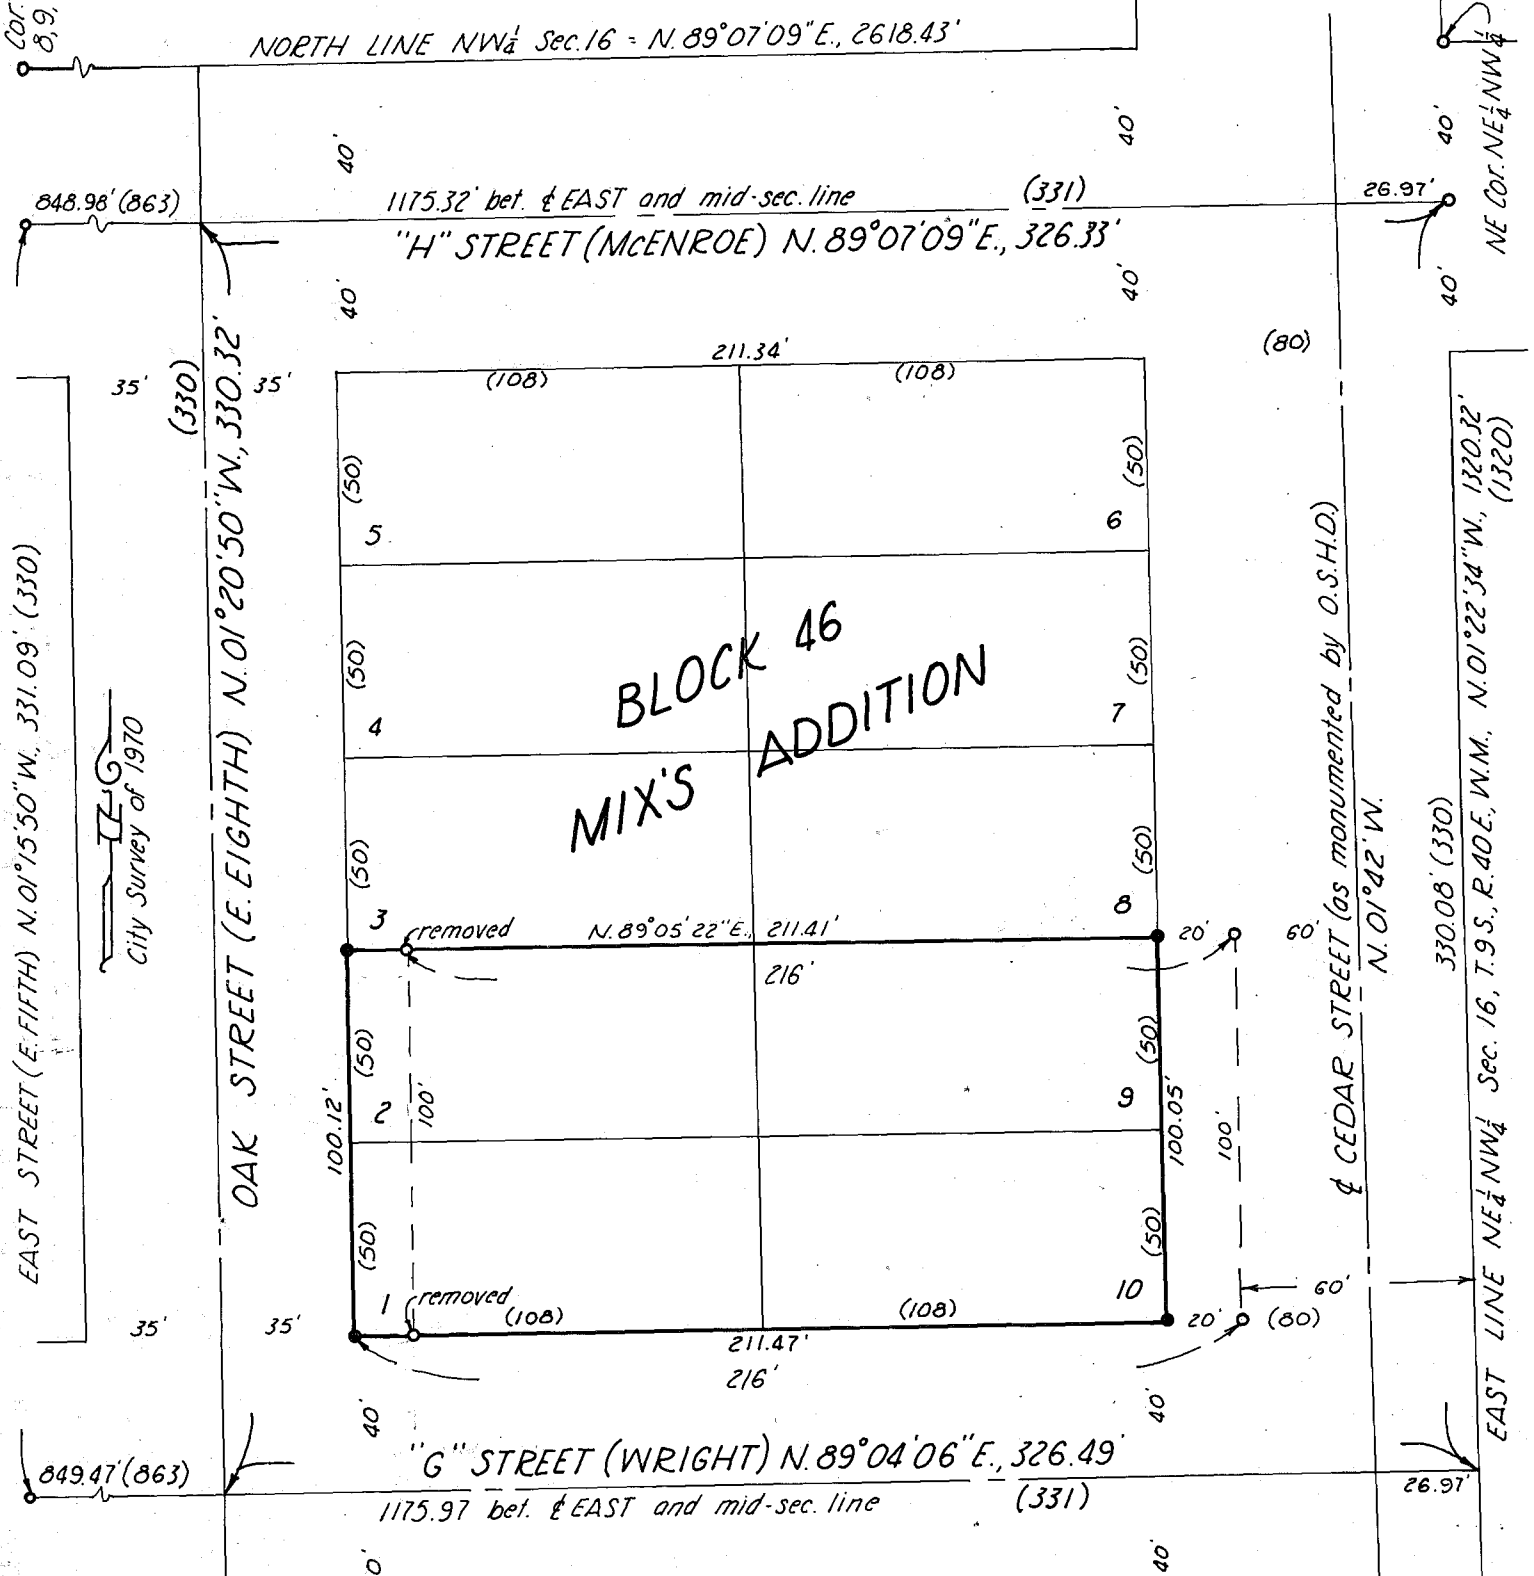

BLOCK 46
MIX'S
ADDITION

- LEGEND
- Found mon. of record
 - Set $\frac{5}{8}$ " x 30" rebar
 - () Original Plat record

MAP OF SURVEY

Surveyed March 23, 1979 1"=50'
for Harvey Ewing

FILED April 4, 1979
BAKER COUNTY SURVEYOR
SURVEY NO. 9-40-147

This Survey amends Survey of June 15, 1977, filed July 5, 1977; Cedar Street is recorded 80 feet wide in Deed Book "O" at Page 227, not 60 feet as shown in other County records.

REGISTERED
PROFESSIONAL
LAND SURVEYOR

William L. Hanley

OREGON
JULY 14, 1978
WILLIAM L. HANLEY
1639