


**NARRATIVE TO RELOCATION OF LOST STREET MONUMENTS**

The street monument at Campbell St. and Fourteenth St. (North) is relocated at the intersection of the centerline of Campbell St. between Fourteenth St. (South) and Fifteenth St. (South) with the extended line of monuments along Fourteenth St. (North) between "A" St. and "B" St.

The street monument at Campbell St. and Thirteenth St. (North) is relocated midway between the intersection at Twelfth St. and Campbell St. and the relocated intersection at Fourteenth St. (North) and Campbell St.

The intersection at "A" St. and Thirteenth St. (North) is relocated at the intersection of the line of monuments along "A" St. between Fourteenth St. (North) and Twelfth St. with the line of monuments along Thirteenth St. (North) between "C" St. and the relocated intersection at Thirteenth St. (North) and Campbell St.

- LEGEND**
- ◻ Found street monument in box.
  - Relocated street monument.
  - Set  $\frac{3}{8}$ " x 30" rebar.
  - ( ) Original Plat record

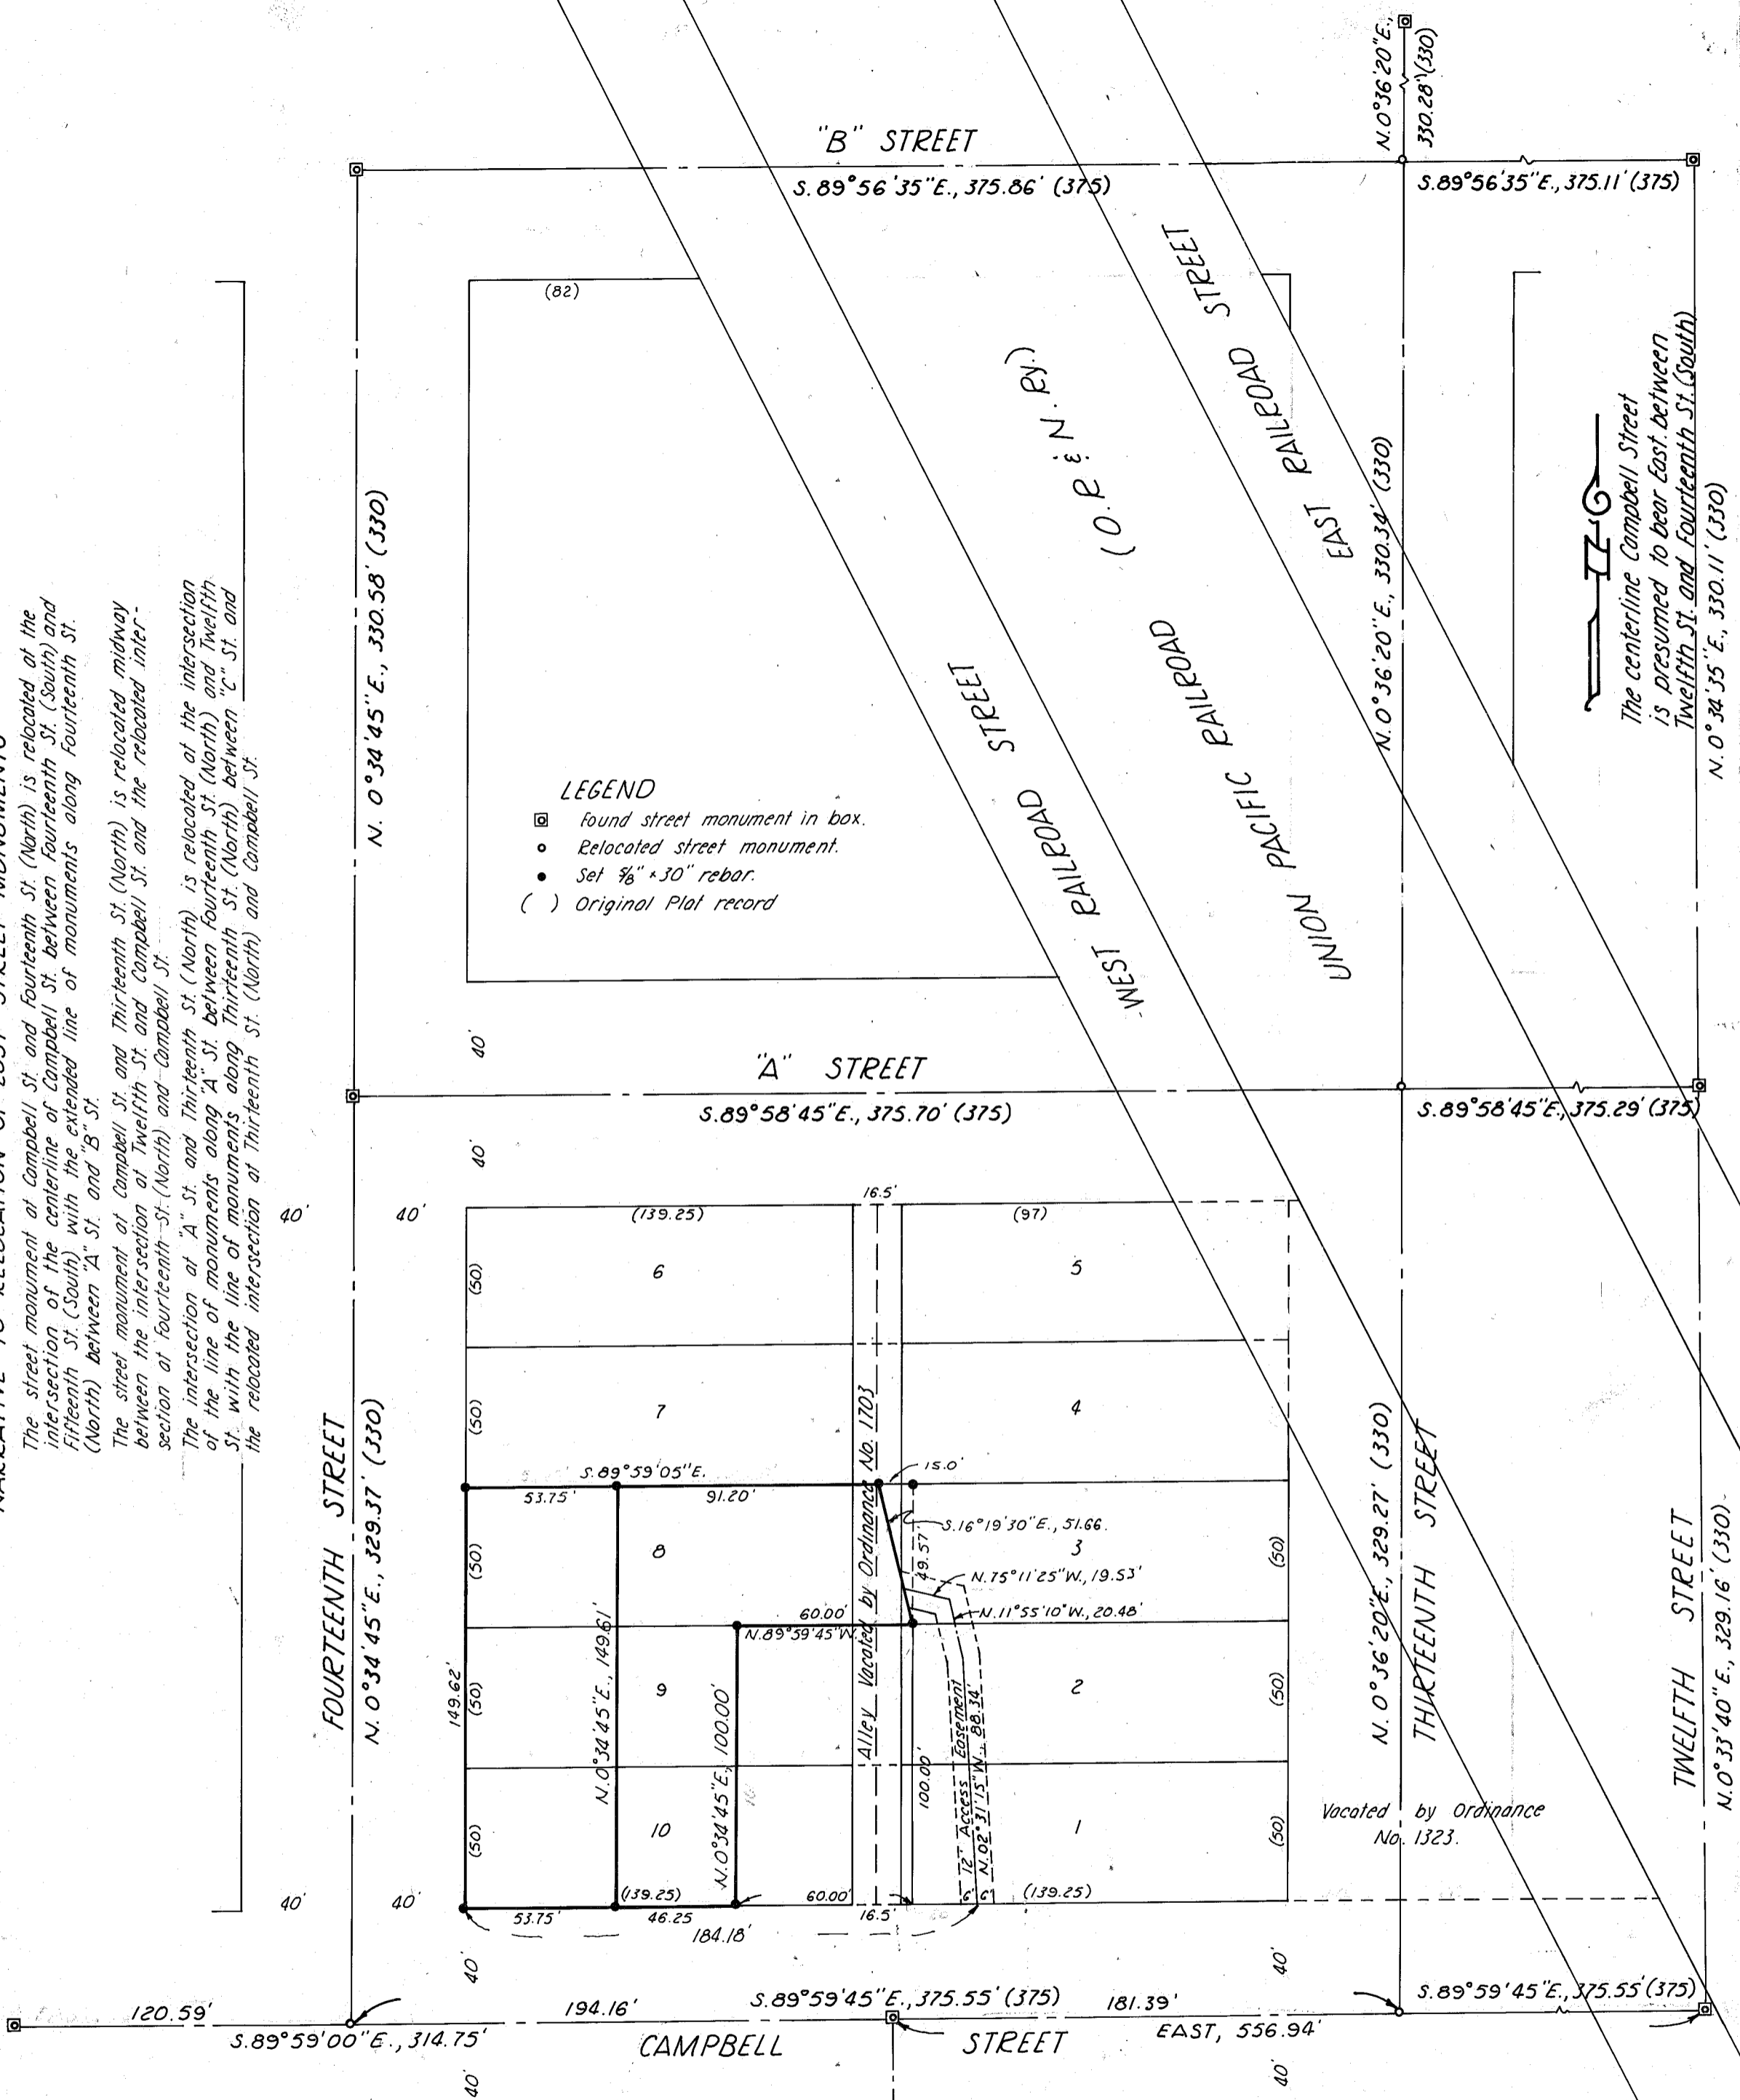

FILED April 20, 1979  
 BAKER COUNTY SURVEYOR  
 SURVEY NO. 9-40-152 BC

**MAP OF SURVEY**  
 IN LOTS 3, 8, 9 & 10, BLOCK 17, B.W. LEVENS ADD'N  
 TO BAKER, OREGON

Surveyed April 4, 5 & 13, 1979  
 For Dick Haynes

Scale 1"=50'

REGISTERED  
 PROFESSIONAL  
 LAND SURVEYOR

William L. Hanley

OREGON  
 JULY 14, 1978  
 WILLIAM L. HANLEY  
 1639