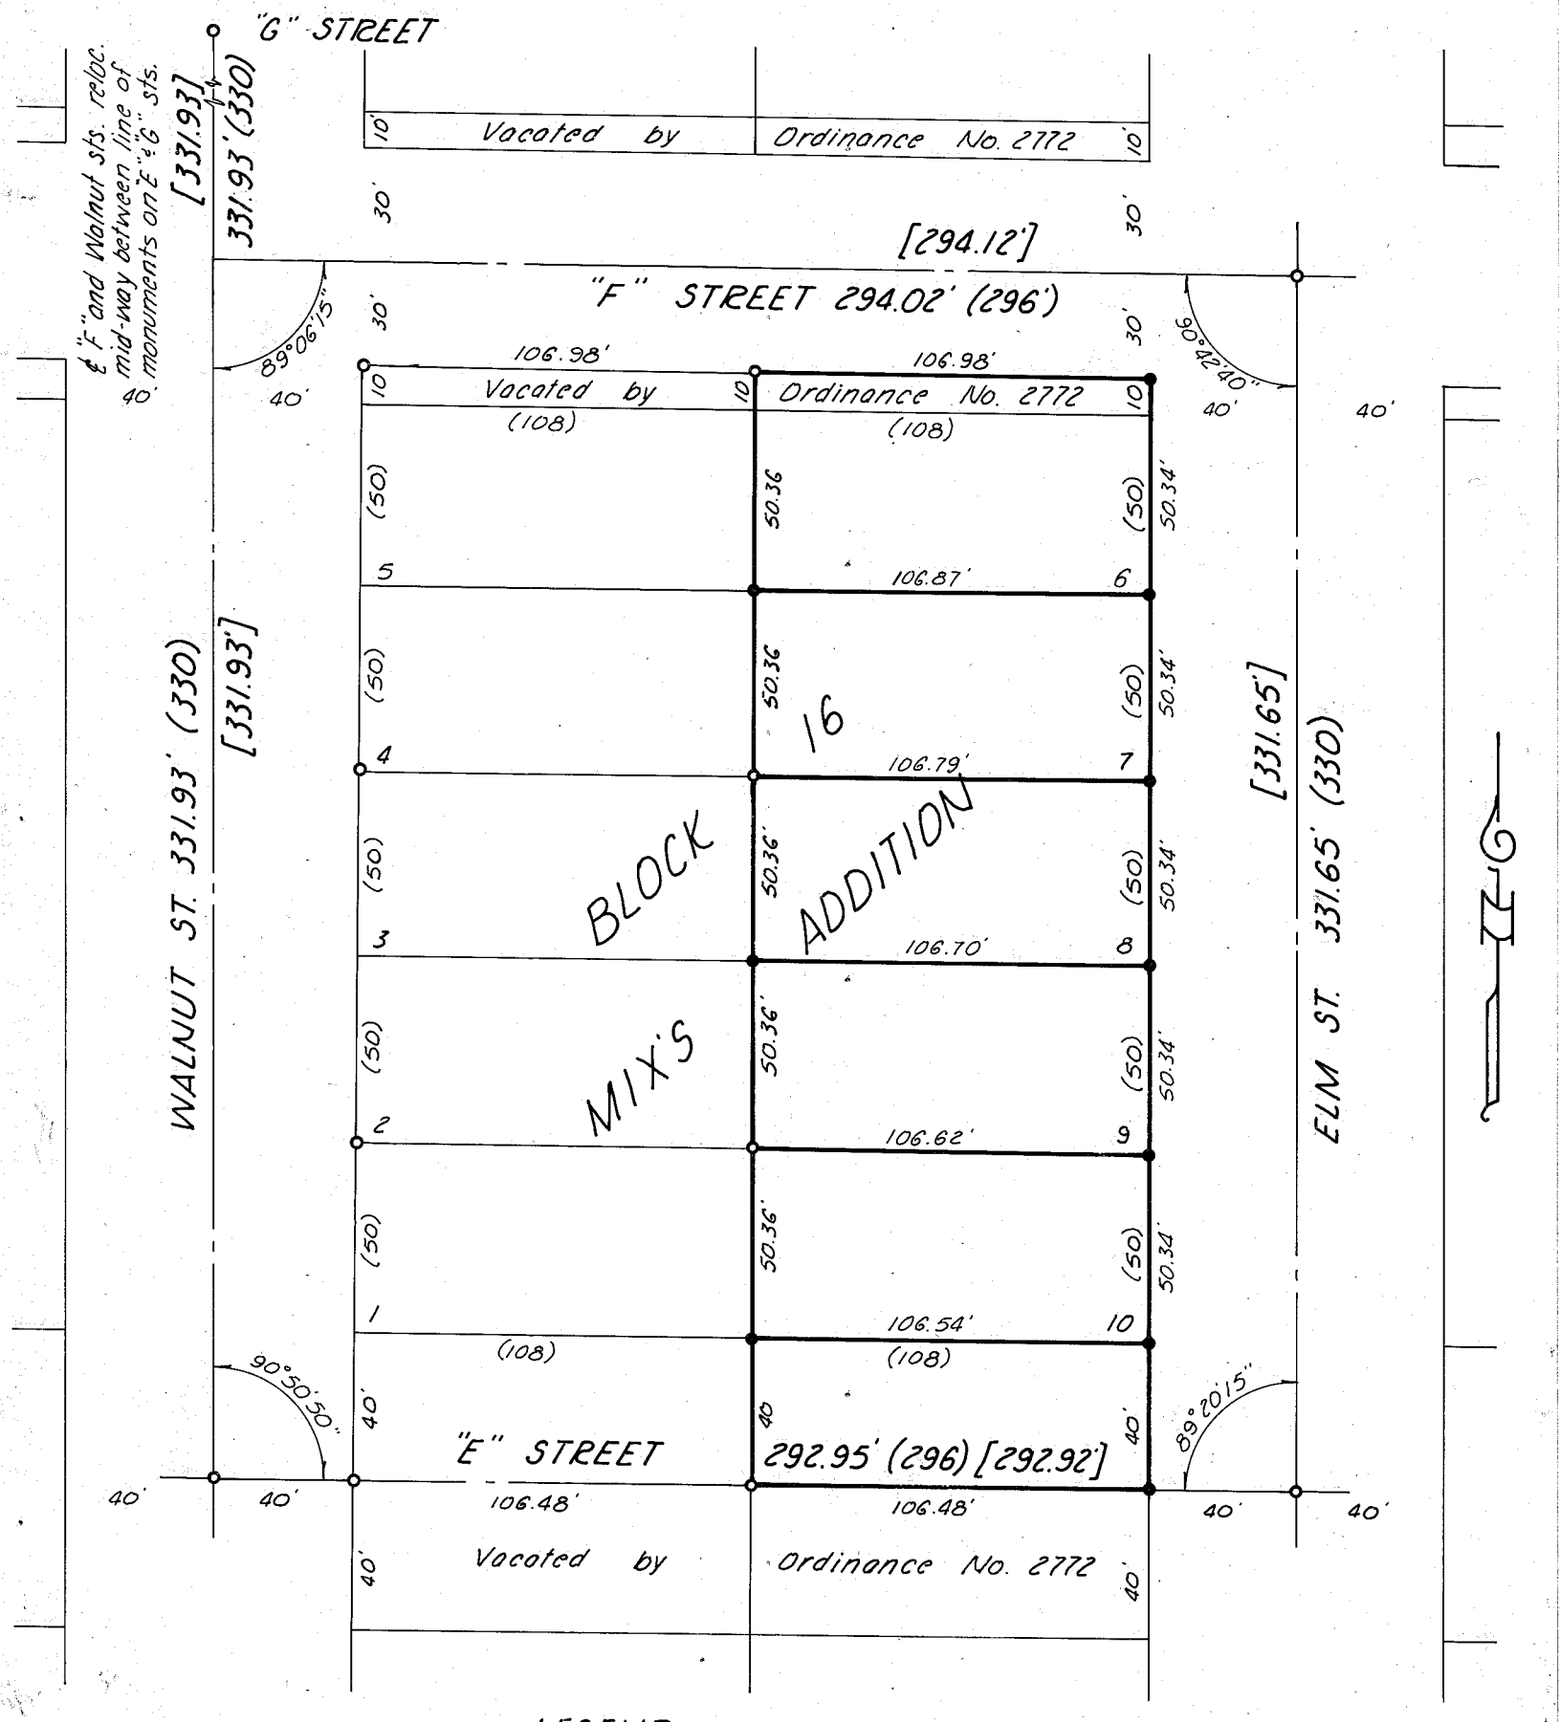

LEGEND

- ○ FOUND MONUMENT OF RECORD
- ● SET 5/8" × 30" REBAR
- ( ) ORIGINAL PLAT DISTANCE
- [ ] 1974 RESURVEY DISTANCE

REFERENCE: Survey filed March 28, 1979 for Aaron Densley

REGISTERED PROFESSIONAL LAND SURVEYOR
James D. Hanley
OREGON
SEPTEMBER 23, 1977
JAMES D. HANLEY
1206

MAP OF SURVEY

Surveyed Sept. 24, 1979 Scale 1" = 50'

FOR EVELYN TOLLES

FILED Sept. 26, 1979
BAKER COUNTY SURVEYOR
SURVEY NO. 9-40-165 B