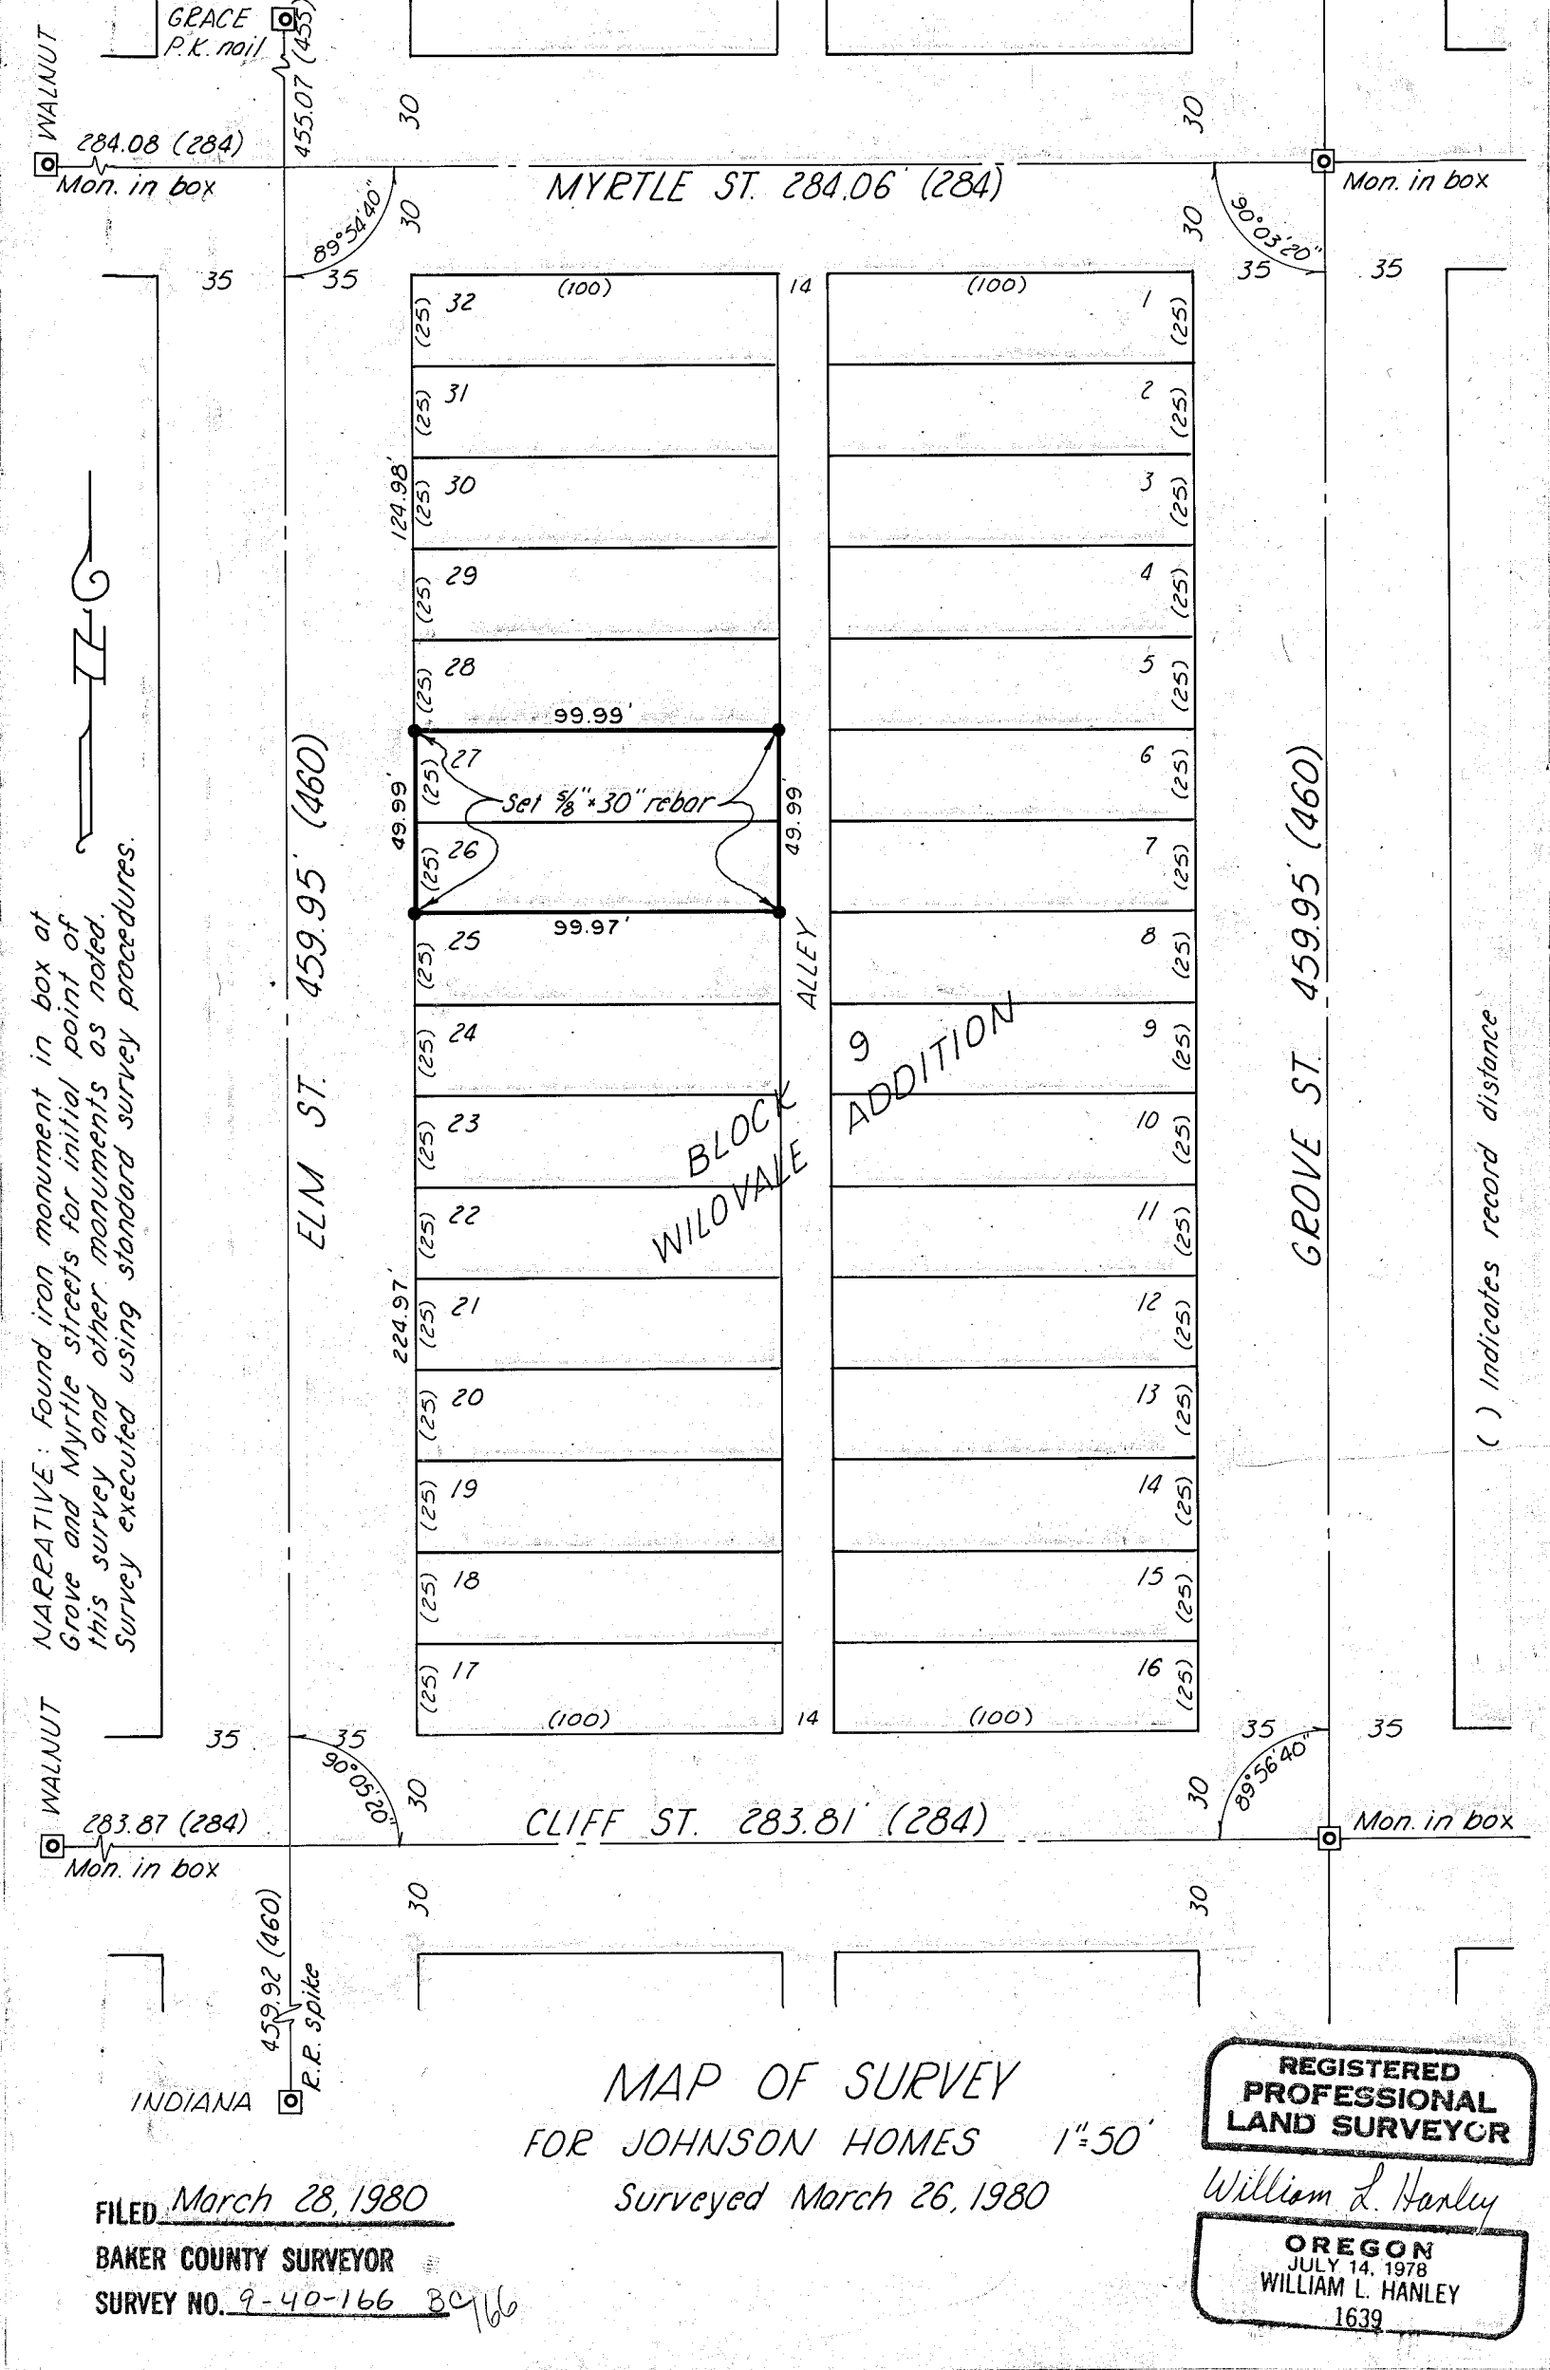

MAP OF SURVEY

FOR JOHNSON HOMES 1"=50'

Surveyed March 26, 1980

REGISTERED PROFESSIONAL LAND SURVEYOR

William L. Hanley

OREGON
JULY 14, 1978
WILLIAM L. HANLEY
1639

FILED March 28, 1980

BAKER COUNTY SURVEYOR

SURVEY NO. 9-40-166 BC 166