Lot Survey of Lot 1, Block 1, Edgewater Addition, City of Baker, Oregon

For Harry Burdett — February 21, 1981 — Scale 1" = 40'

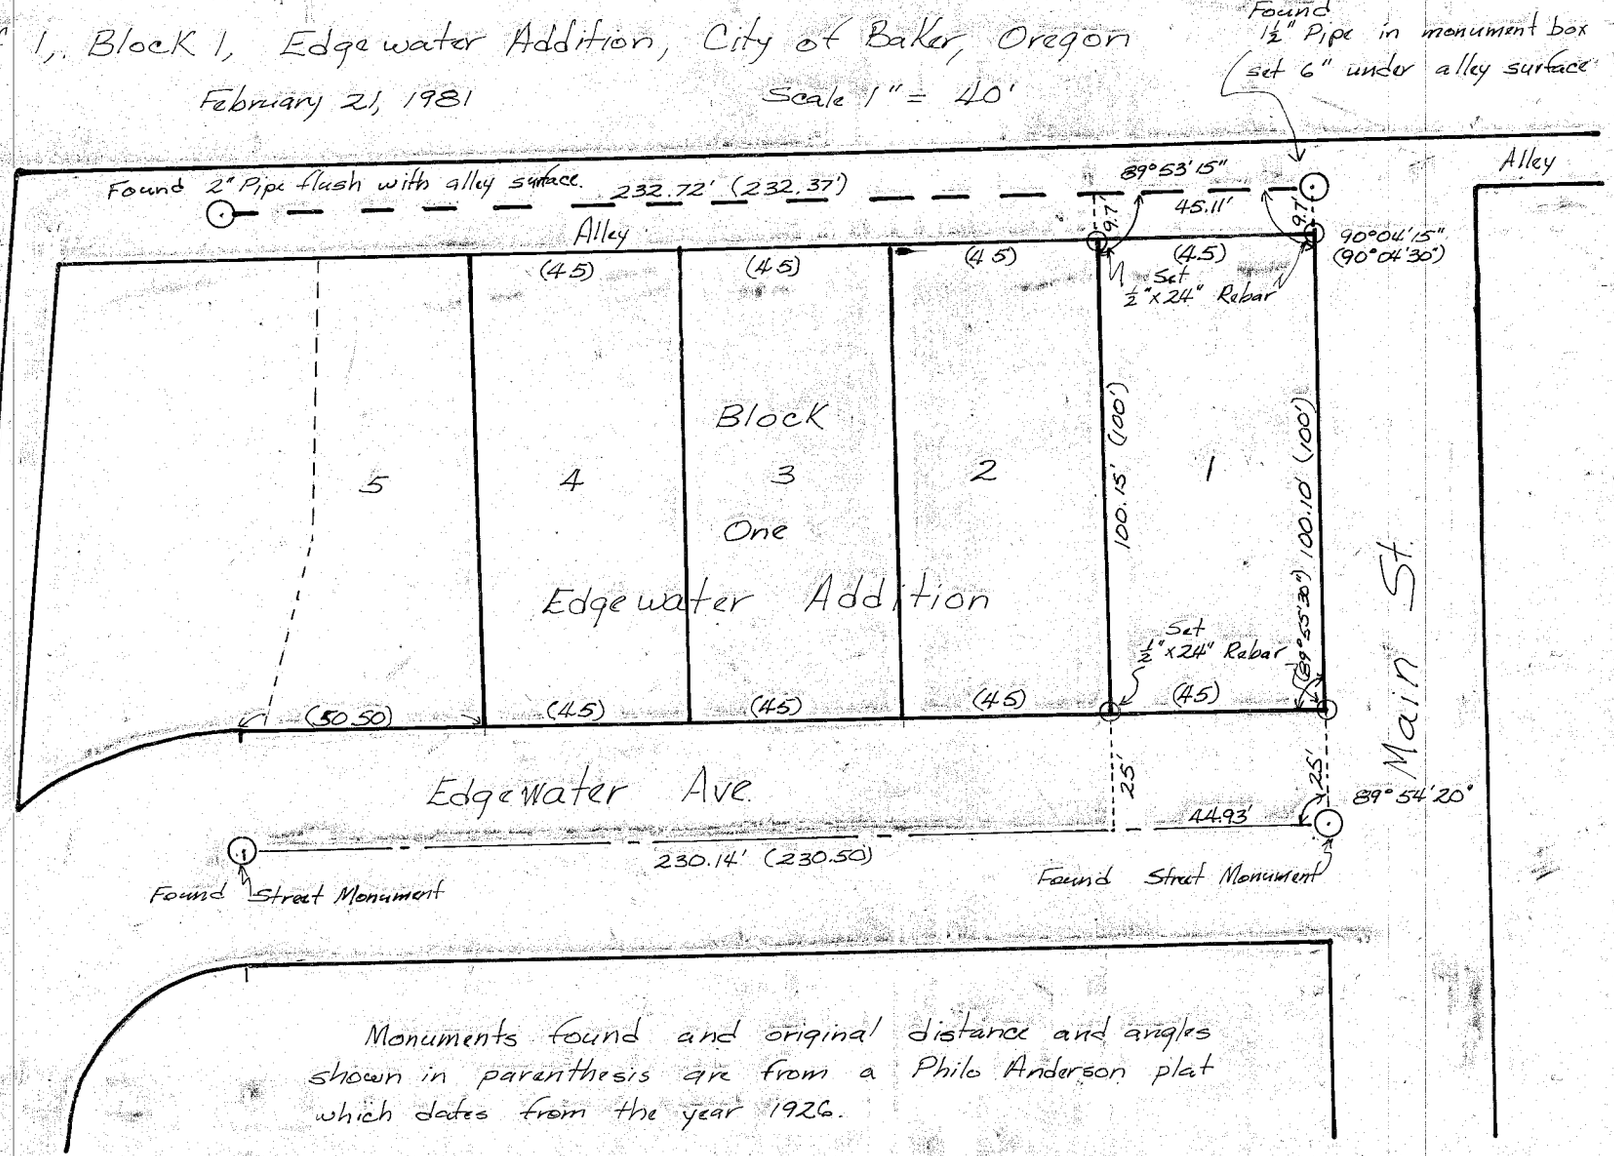

REGISTERED PROFESSIONAL LAND SURVEYOR

Leland Lee Myers

OREGON
JULY 9, 1965
LELAND LEE MYERS
699

FILED March 3, 1981
BAKER COUNTY SURVEYOR
SURVEY NO. 9-40-171

Monuments found and original distance and angles shown in parenthesis are from a Philo Anderson plat which dates from the year 1926.