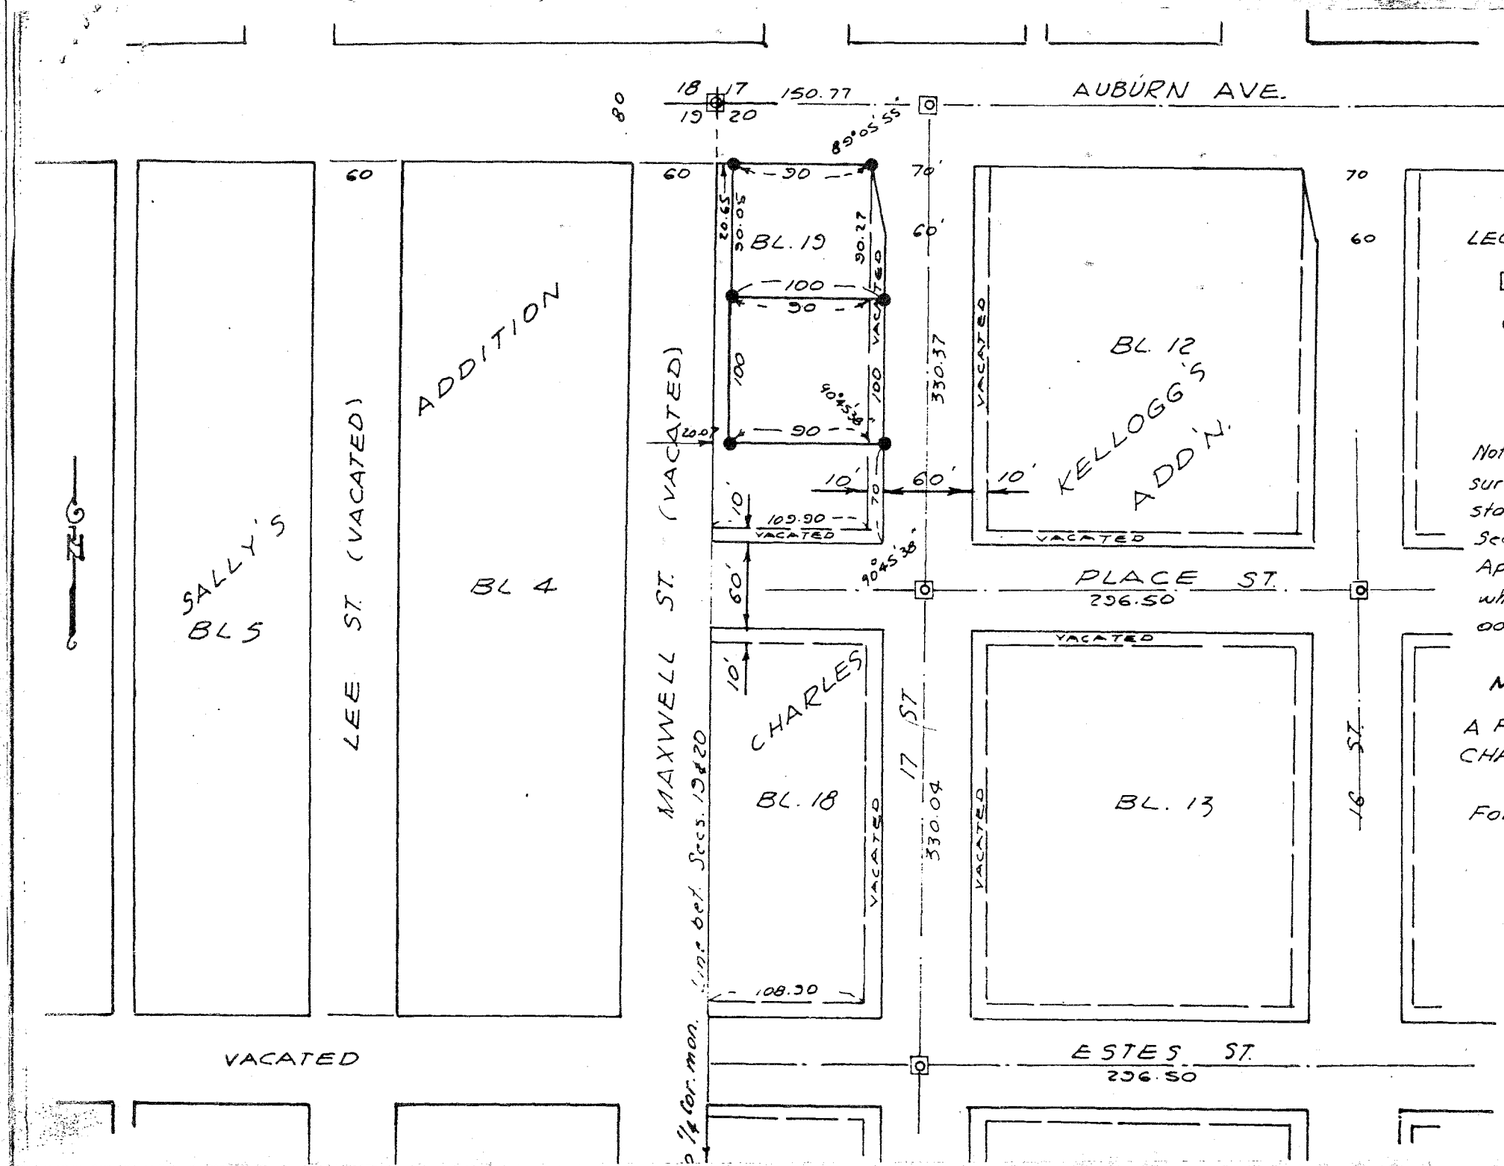

Approved for filing

Rodger L. Bennett

City of Baker
By: Rodger L. Bennett,
City Manager

Date: 3/25/81

LEGEND

⊡ Found, city monument

● Set 5/8" x 30" rebar

Note: City monuments found, and survey performed according to standard survey procedures. See map of survey filed Apr. 27, 1972 of Kellogg's Addn. which shows West line of the addition is the section line.

MAP OF SURVEY

A PARCEL IN BLOCK 19,
CHARLES KELLOGG'S ADD'N.
Baker Oregon
For Allen Phillips.
March 1981
Scale 1" = 100'

REGISTERED PROFESSIONAL LAND SURVEYOR

James D. Hanley

OREGON
SEPTEMBER
JAMES D. HANLEY
1206