


O.S.H.D. HWY. NO. 7

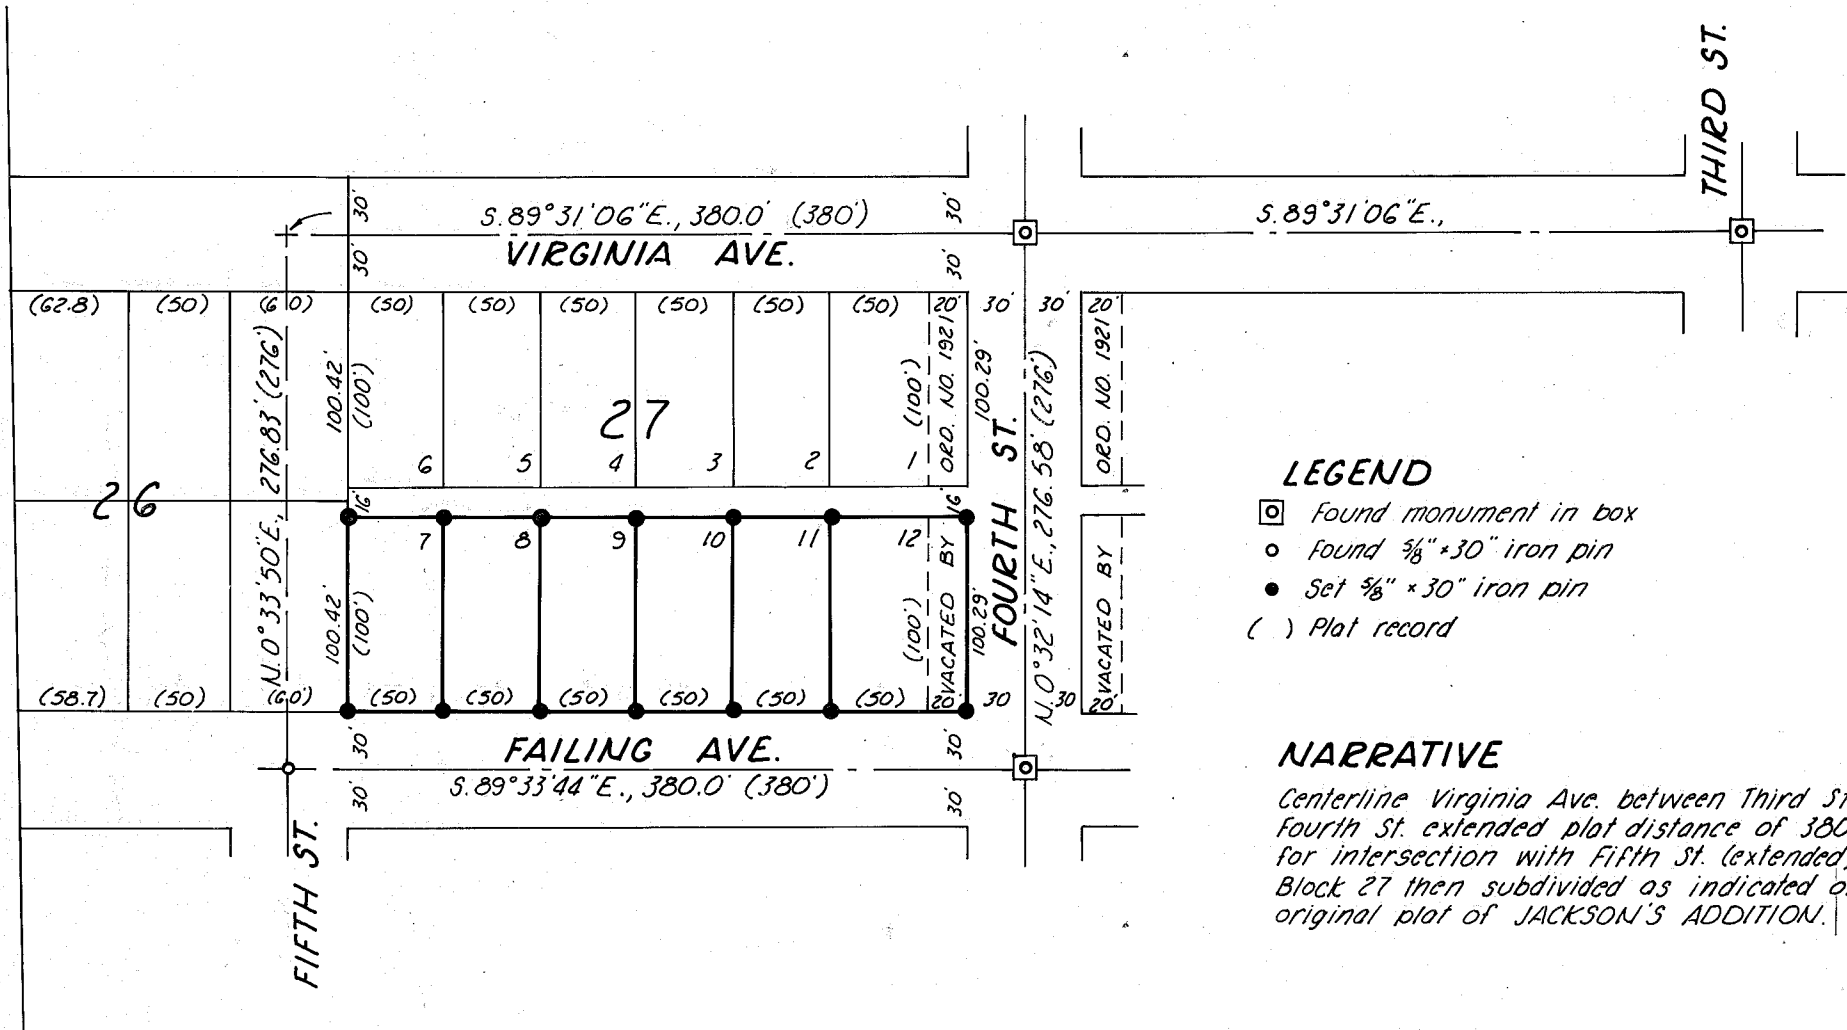

LEGEND

- ◻ Found monument in box
- Found 5/8" x 30" iron pin
- Set 5/8" x 30" iron pin
- () Plat record

NARRATIVE

Centerline Virginia Ave. between Third St. and Fourth St. extended plat distance of 380 feet for intersection with Fifth St. (extended). Block 27 then subdivided as indicated on original plat of JACKSON'S ADDITION.

**MAP OF SURVEY
IN BLOCK 27, JACKSON'S ADDITION
TO BAKER, OREGON**

FILED Nov. 2, 1981
BAKER COUNTY SURVEYOR
SURVEY NO. 9-40-182

Surveyed Oct. 9 & 22, 1981 Scale 1"=100'
FOR RON DAVIS

REGISTERED
PROFESSIONAL
LAND SURVEYOR

William L. Hanley

OREGON
JULY 14, 1978
WILLIAM L. HANLEY
1639