


CHARLES BRUNING COMPANY, Inc.
 657-10
 TO X TO THE GAGE
 MADE IN U.S.A.

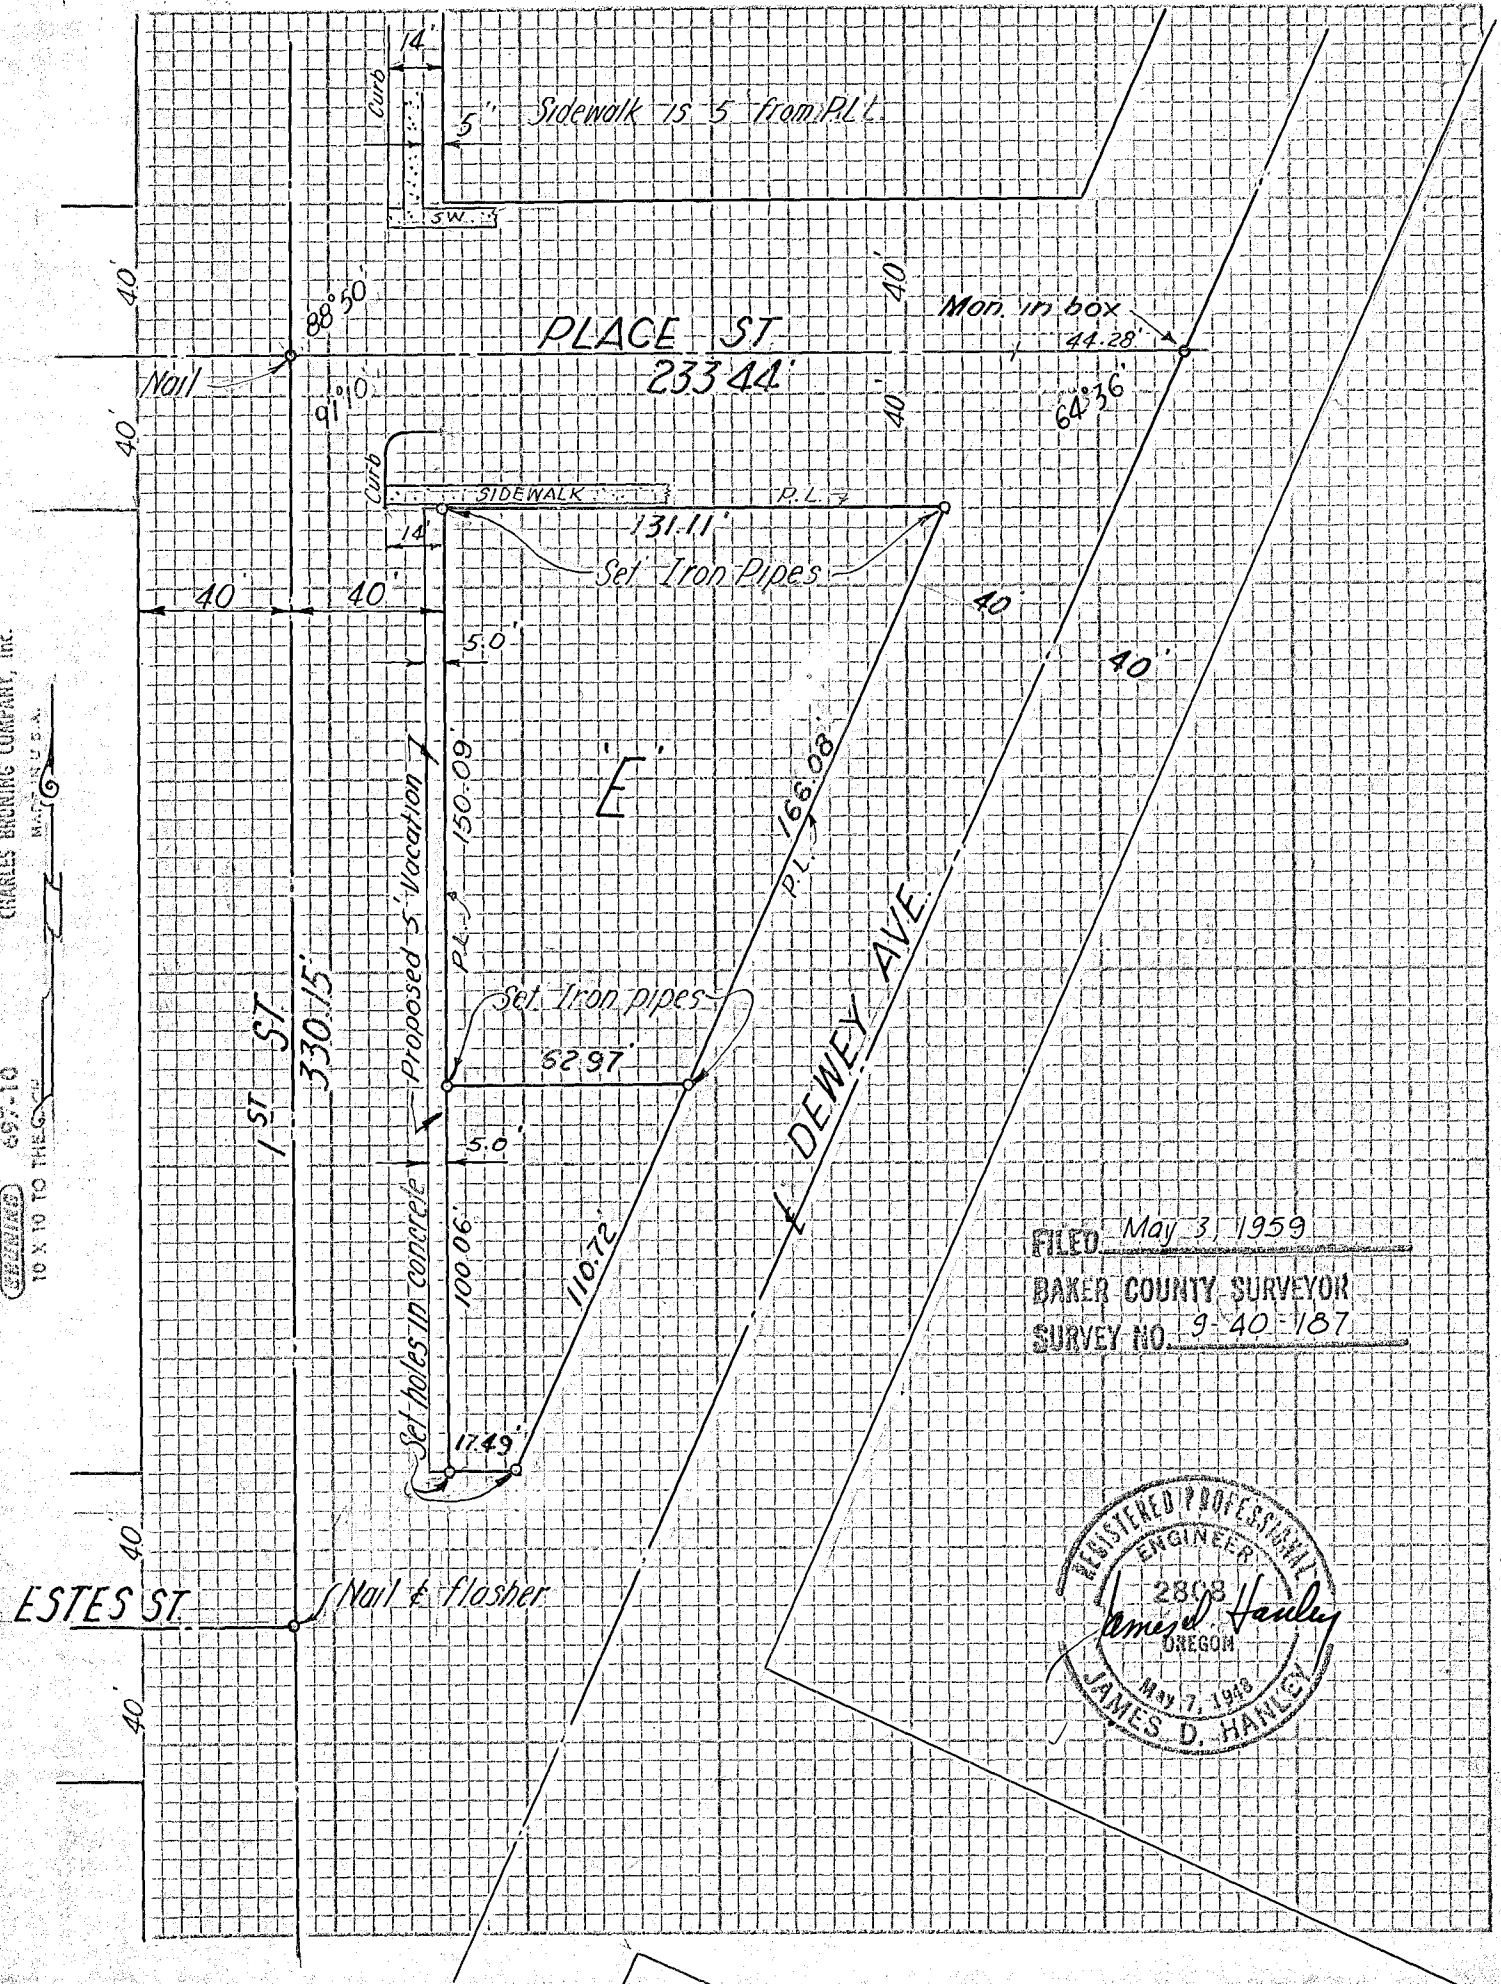

FILED May 3, 1959
 BAKER COUNTY SURVEYOR
 SURVEY NO. 9-40-187

