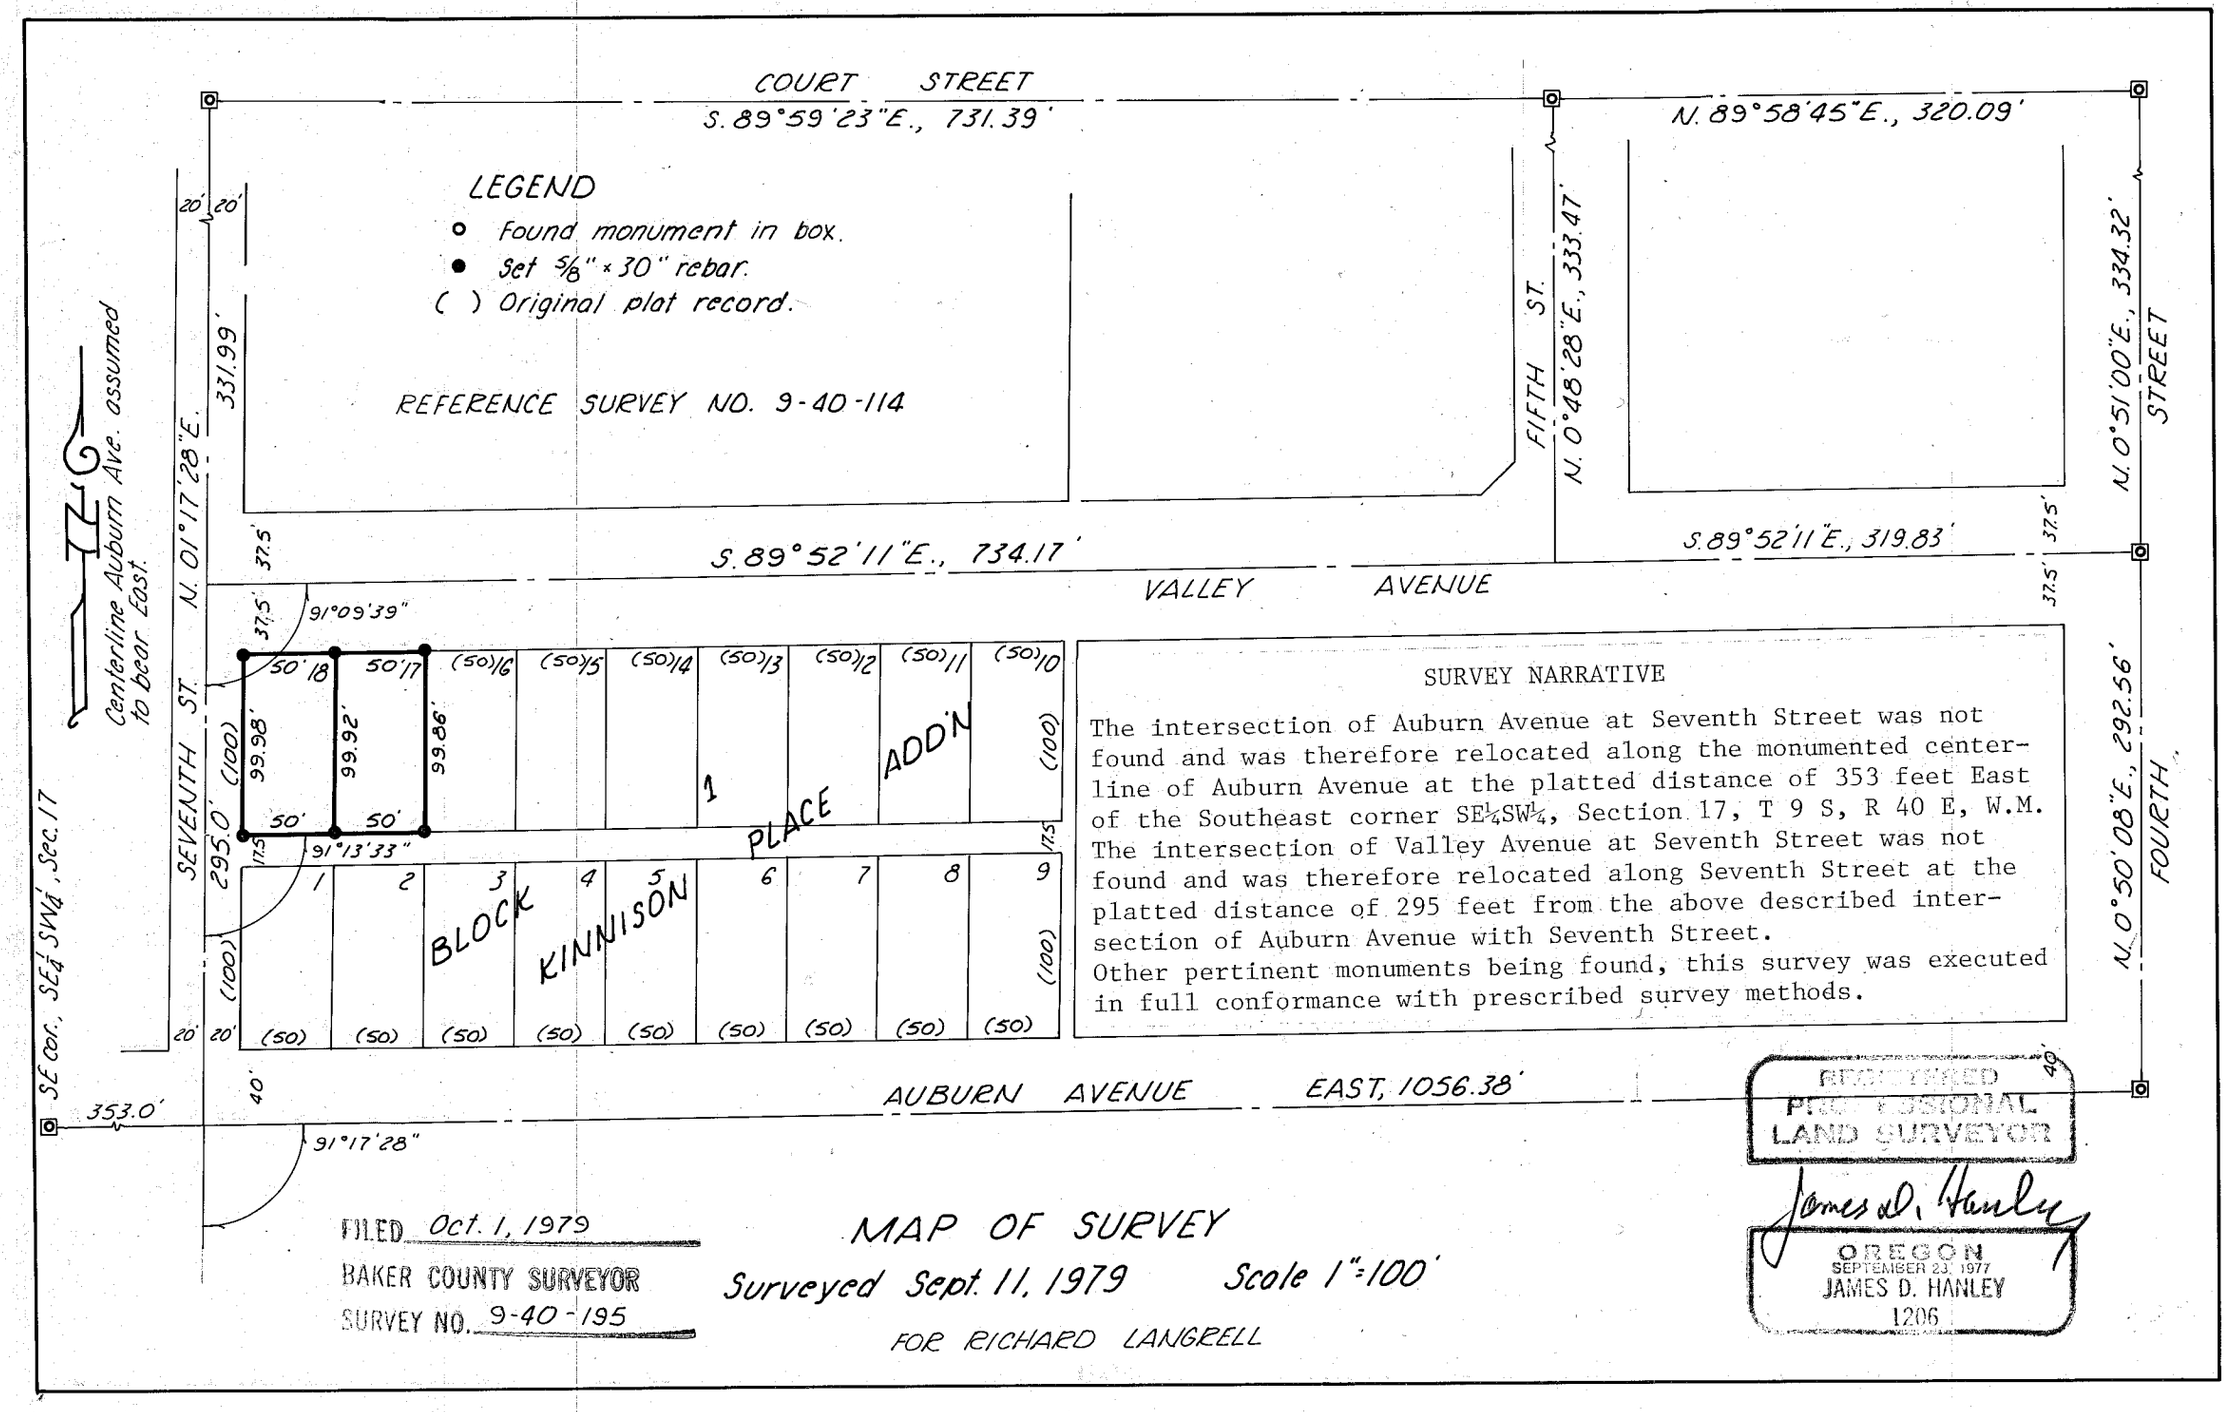

SURVEY NARRATIVE

The intersection of Auburn Avenue at Seventh Street was not found and was therefore relocated along the monumented center-line of Auburn Avenue at the platted distance of 353 feet East of the Southeast corner SE¼SW¼, Section 17, T 9 S, R 40 E, W.M. The intersection of Valley Avenue at Seventh Street was not found and was therefore relocated along Seventh Street at the platted distance of 295 feet from the above described inter-section of Auburn Avenue with Seventh Street.
Other pertinent monuments being found, this survey was executed in full conformance with prescribed survey methods.

FILED Oct. 1, 1979
BAKER COUNTY SURVEYOR
SURVEY NO. 9-40-195

MAP OF SURVEY

Surveyed Sept. 11, 1979 Scale 1"=100'

FOR RICHARD LANGRELL