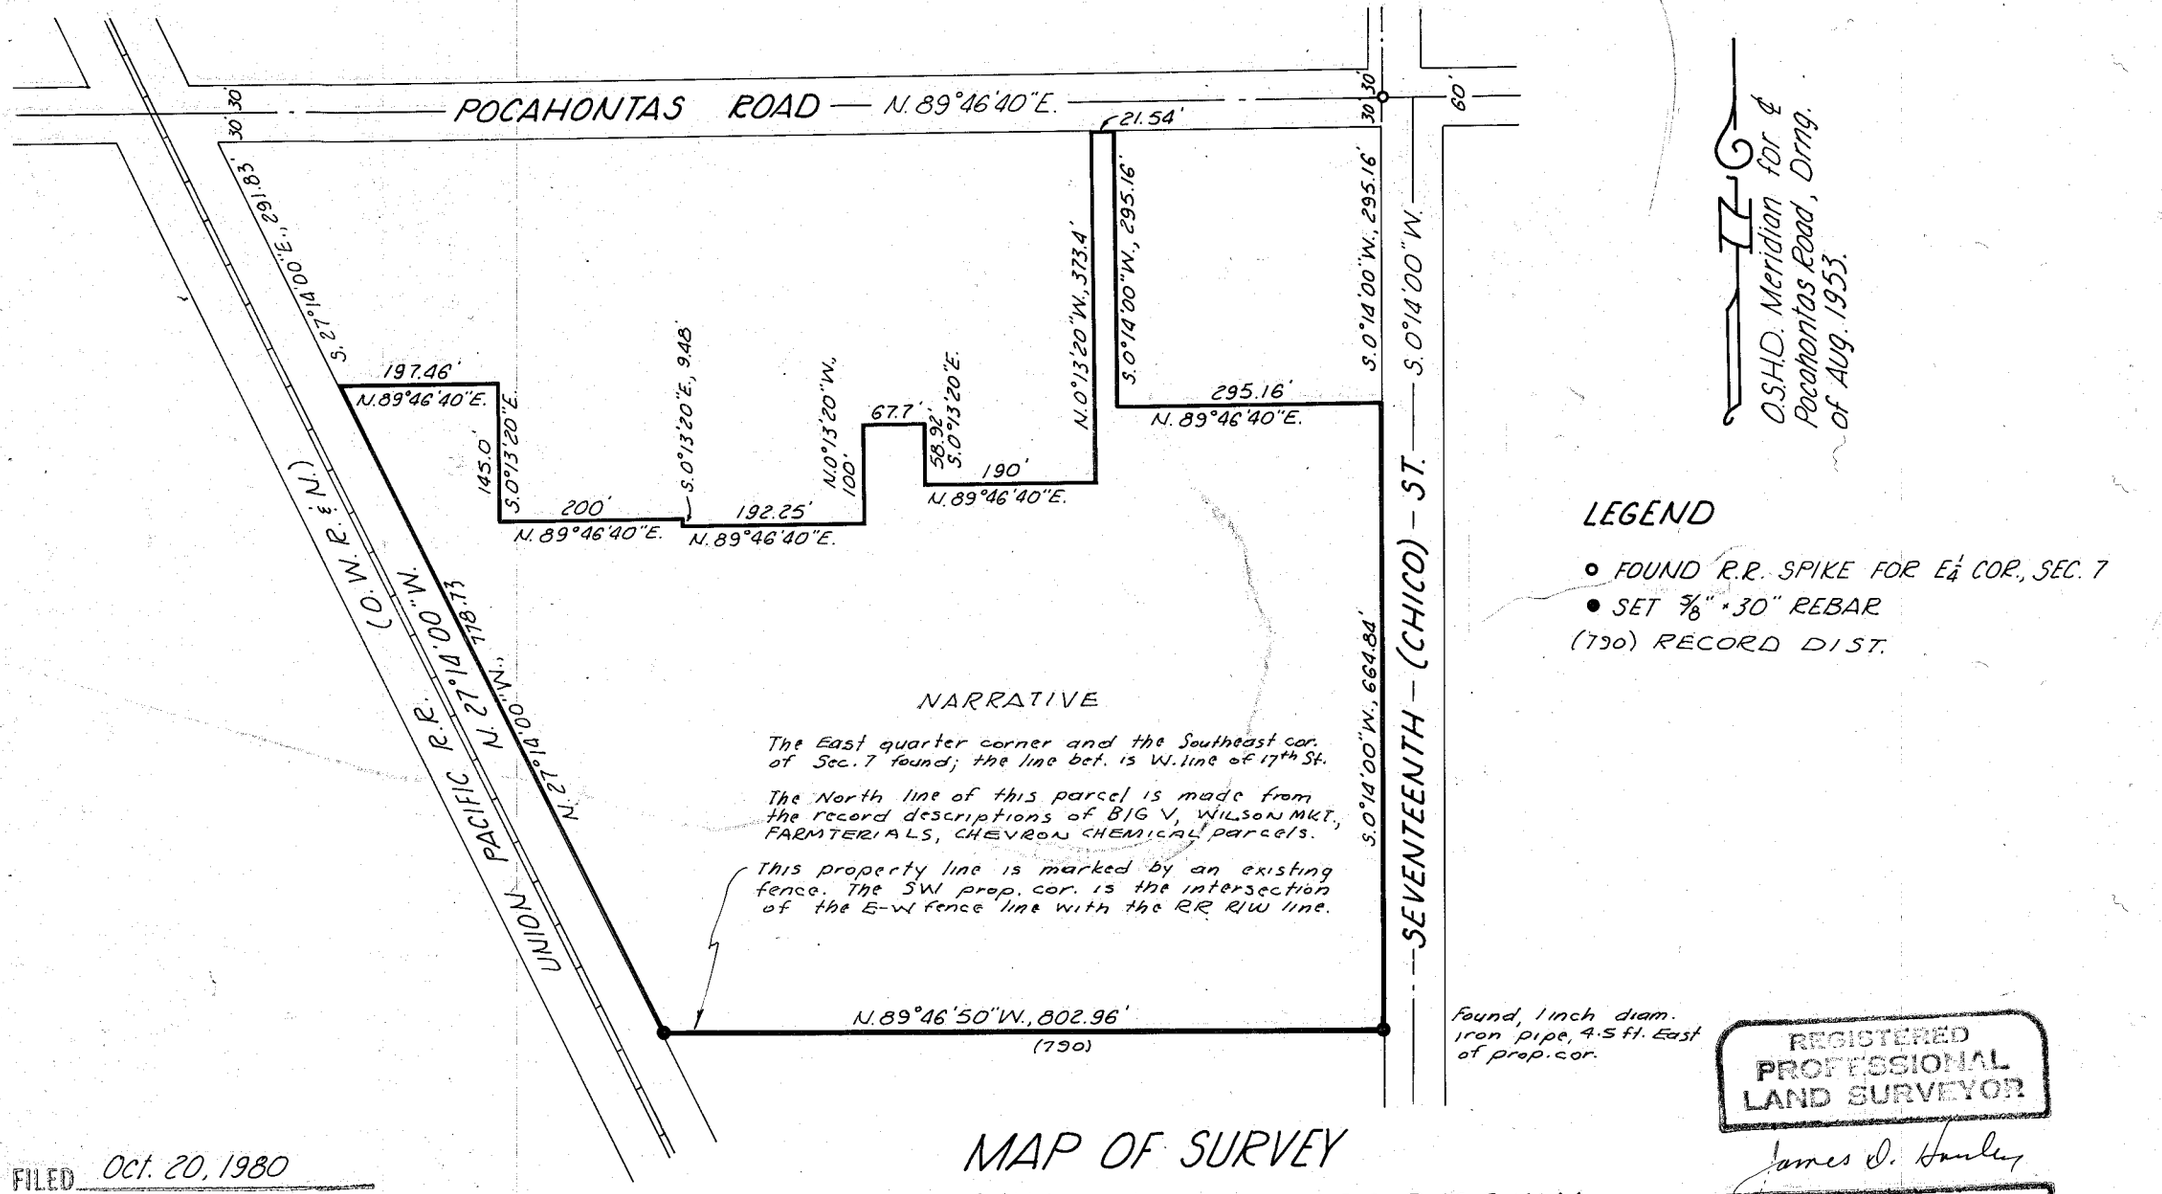

O.S.H.D. Meridian for ℄ Pocahontas Road, Orng. of Aug. 1953.

LEGEND

- ○ FOUND R.R. SPIKE FOR E¼ COR, SEC. 7
- ● SET ⅝" × 30" REBAR
- (790) RECORD DIST.

NARRATIVE

The East quarter corner and the Southeast cor. of Sec. 7 found; the line bet. is W. line of 17th St.

The North line of this parcel is made from the record descriptions of BIG V, WILSON MKT., FARMTERIALS, CHEVRON CHEMICAL parcels.

This property line is marked by an existing fence. The SW prop. cor. is the intersection of the E-W fence line with the RR R/W line.

FILED Oct. 20, 1980
BAKER COUNTY SURVEYOR
SURVEY NO. 9-40-196A

MAP OF SURVEY

IN THE NE¼ SE¼ SECTION 7, T. 9 S., R. 40 E., W.M.

Surveyed Sept. 15 & 26, 1980 Scale 1" = 200'

For Dick Haynes

REGISTERED PROFESSIONAL LAND SURVEYOR

James D. Hanley

OREGON
SEPTEMBER 23, 1977
JAMES D. HANLEY
1206

Baker, Oregon