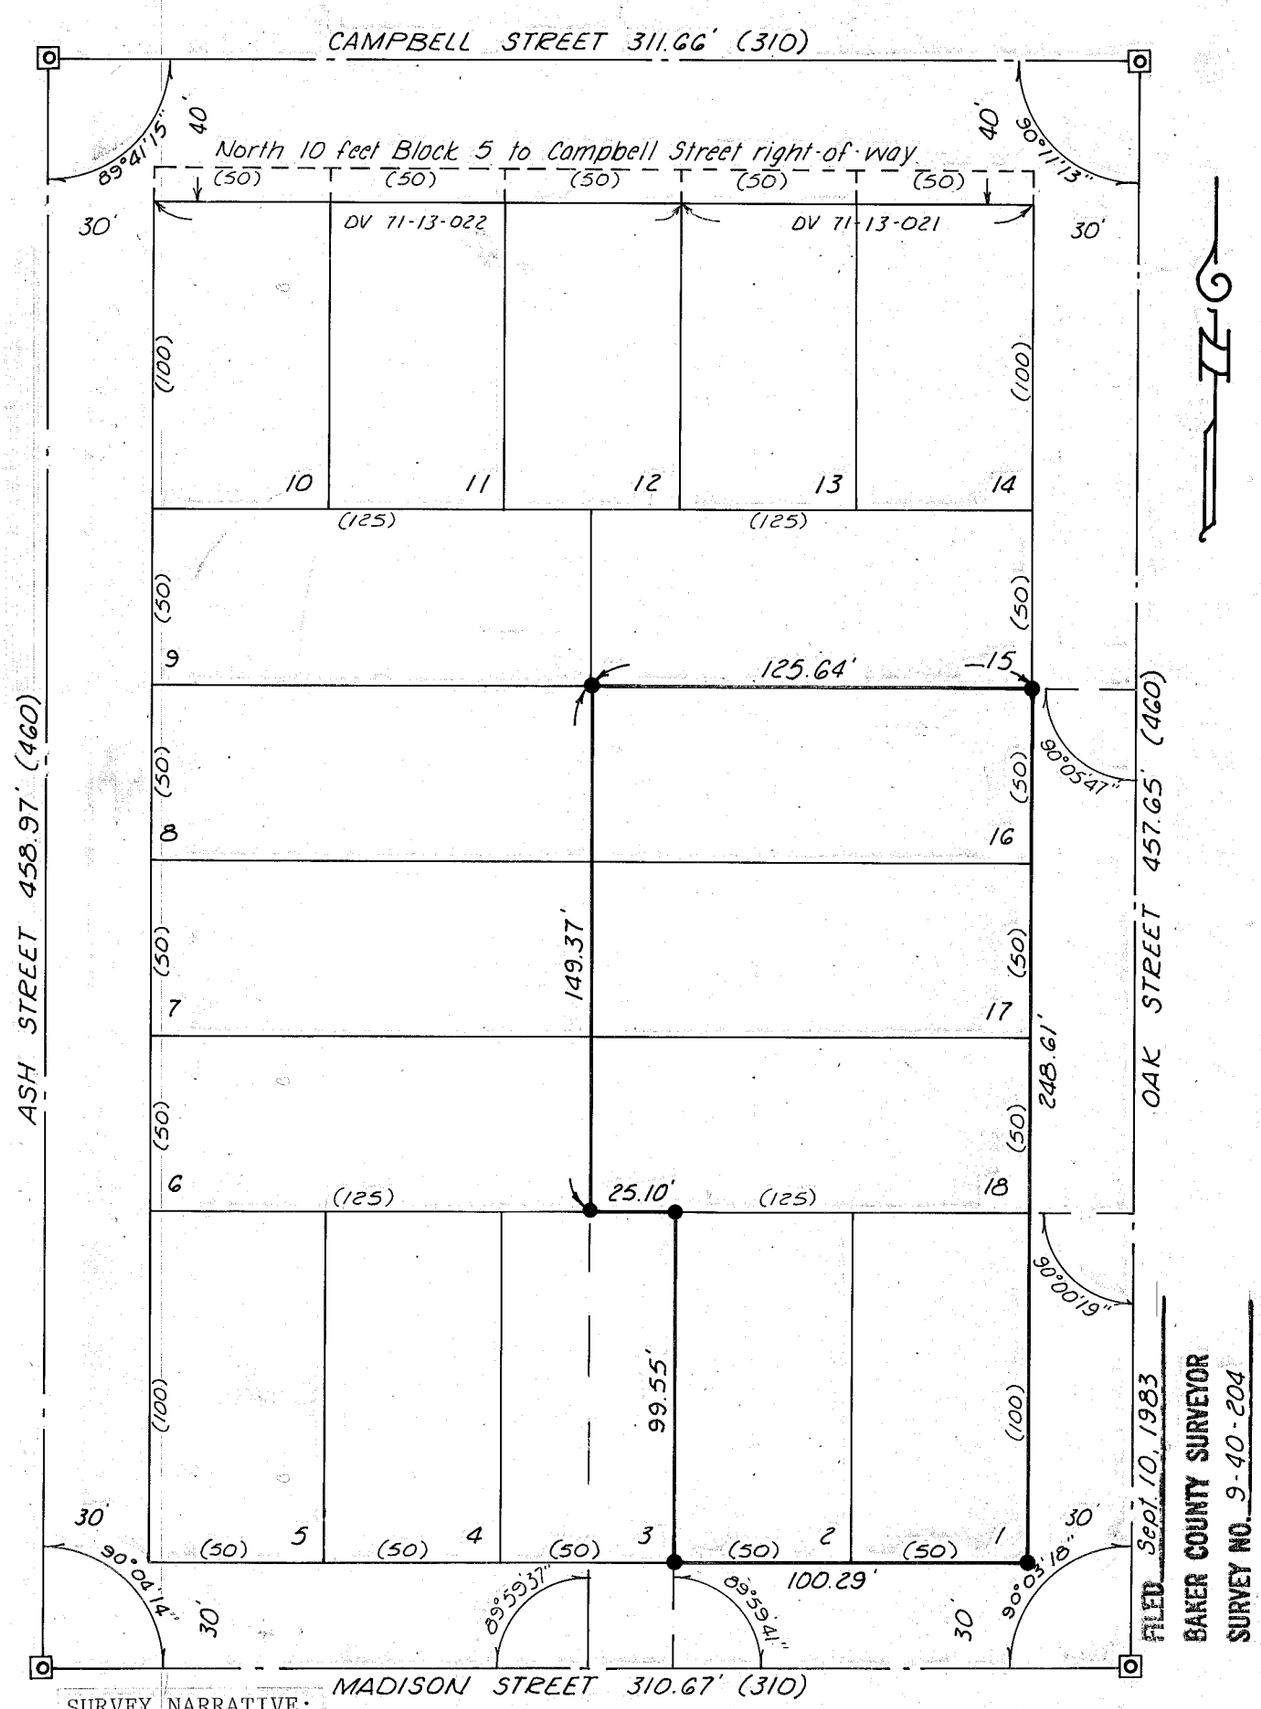

FILED Sept. 10, 1983
BAKER COUNTY SURVEYOR
SURVEY NO. 9-40-204

SURVEY NARRATIVE:

This survey was performed at the request of Mike Becker, building contractor, for the purpose of monumenting the corners of that property owned by Fong's Tea House, Inc. Monuments were recovered as shown on this plat and lottings were proportioned by prescribed methods. Note that the North 10 feet of Block 5 has been taken for street widening of Campbell Street.

LEGEND

- ⊡ Found monument in box.
- ● Set 5/8"×30" rebar with yellow plastic cap mkd. HANLEY ENGR. PLS 1206
- ( ) Record of official plat.

MAP OF SURVEY
LOTS 1, 2, 16, 17 & 18, BLOCK 5
J. P. ATWOOD'S THIRD ADDITION TO
BAKER CITY, OREGON

Surveyed Aug. 10, 1983 Scale 1"=50'

For Fong's Tea House, Inc.

REGISTERED
PROFESSIONAL
LAND SURVEYOR
William L. Hanley
Baker, Ore.

OREGON
JULY 14, 1978
WILLIAM L. HANLEY
1639