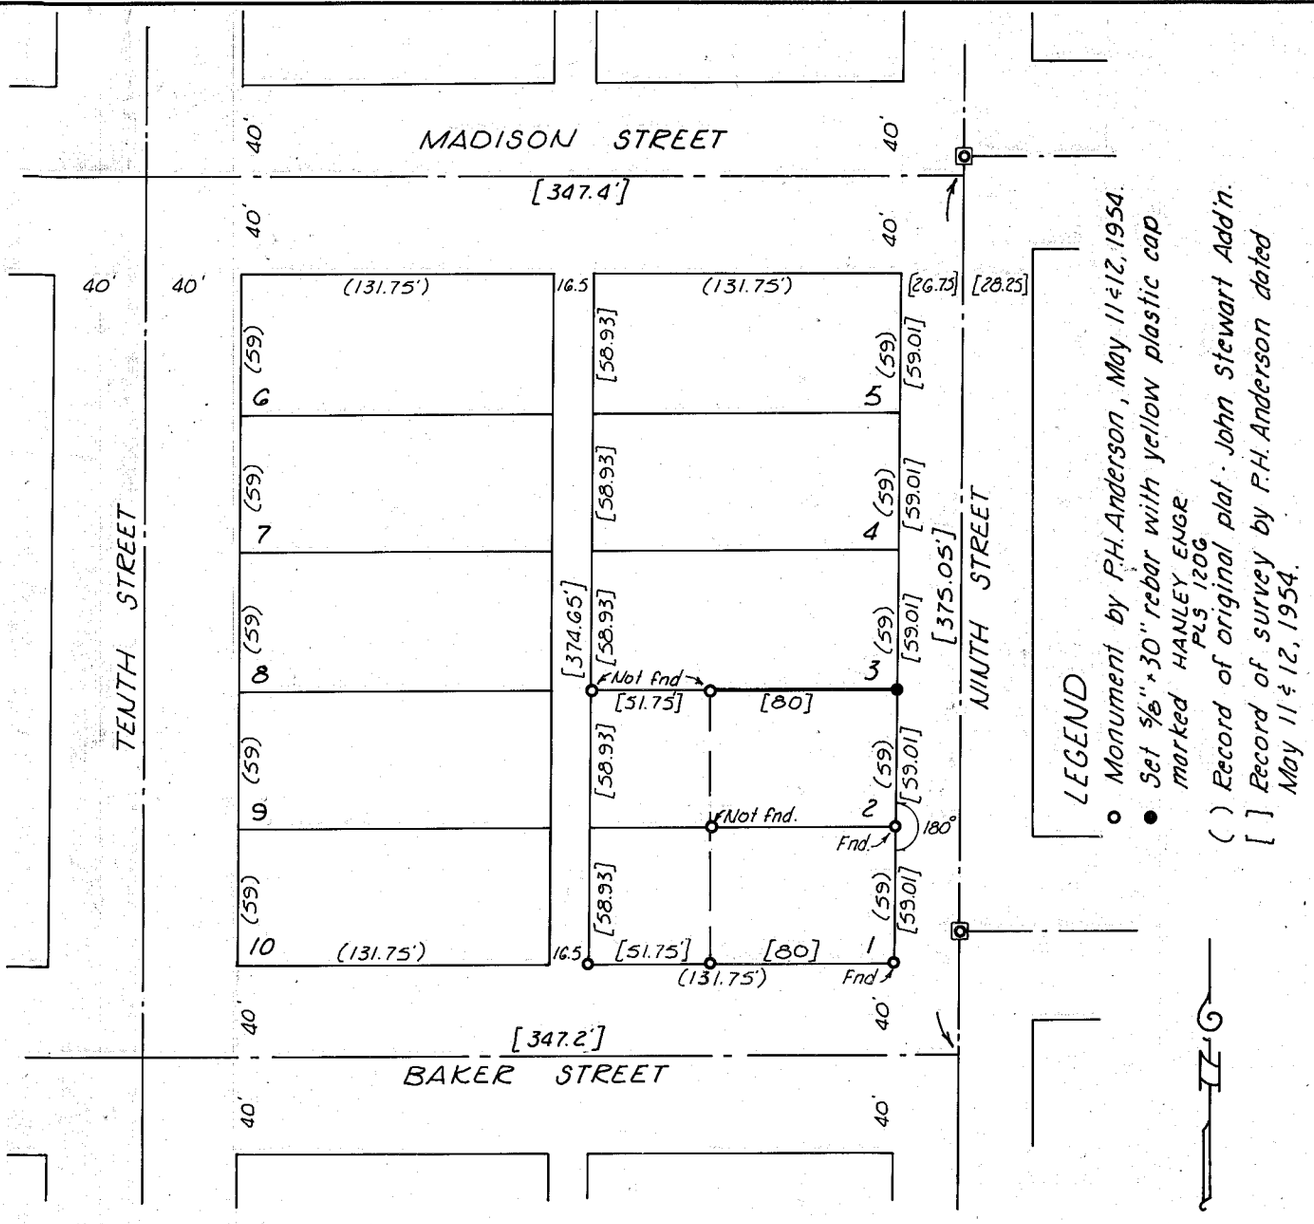

SURVEY NARRATIVE

This survey was performed at the request of Carl Peterson for the purpose of locating the North line and establishing the Northeast corner of Lot 2, Block 2, John Stewart's Addition to Baker, Oregon. Monuments were recovered as shown from a survey performed by Philo H. Anderson, RPE 1257, on May 11 and 12, 1954, and are the basis of this survey.

FILED Jan. 9, 1984
BAKER COUNTY SURVEYOR
SURVEY NO. 9-40-211

REGISTERED PROFESSIONAL LAND SURVEYOR
James D. Hanley
OREGON
SEPTEMBER 23, 1977
JAMES D. HANLEY
1206

RECORD OF SURVEY PLAT
IN BLOCK 2, JOHN STEWART'S ADDITION
TO BAKER, OREGON

Surveyed March 14, 1983 Scale 1"=80'

For Carl Peterson