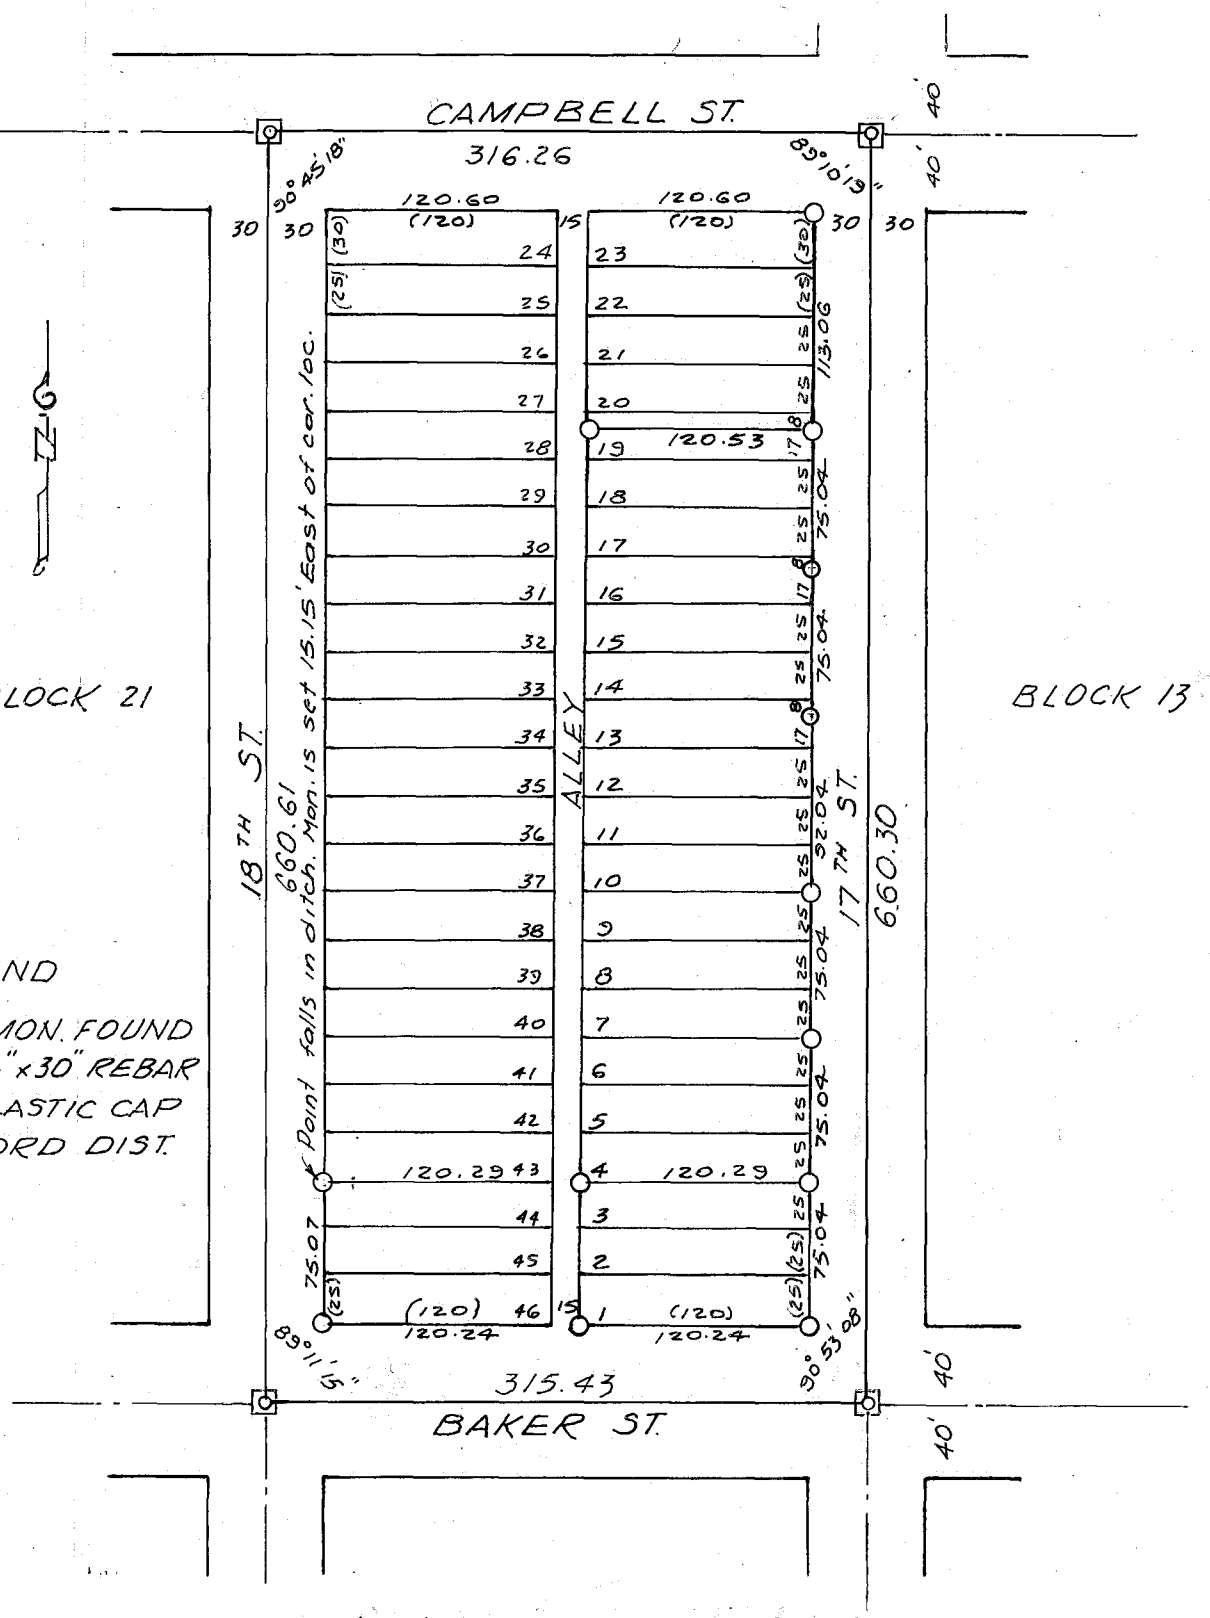

LEGEND

- ▣ CITY MON. FOUND
- ○ SET ½"×30" REBAR W/ PLASTIC CAP
- ( ) RECORD DIST.

All street monuments were found as shown. Standard survey practices, using proportionate measurements then employed.

MAP OF SURVEY

BLOCK 20, STEWART'S SECOND ADD'N.

FOR

H. C. SCHLINGMAN

May, 1979 Scale 1"=100'

FILED Apr 6 1985
BAKER COUNTY SURVEYOR
SURVEY NO. 3-40-223

REGISTERED PROFESSIONAL LAND SURVEYOR

James D. Hanley

OREGON
SEPTEMBER 23, 1977
JAMES D. HANLEY
1206

Baker, Oregon