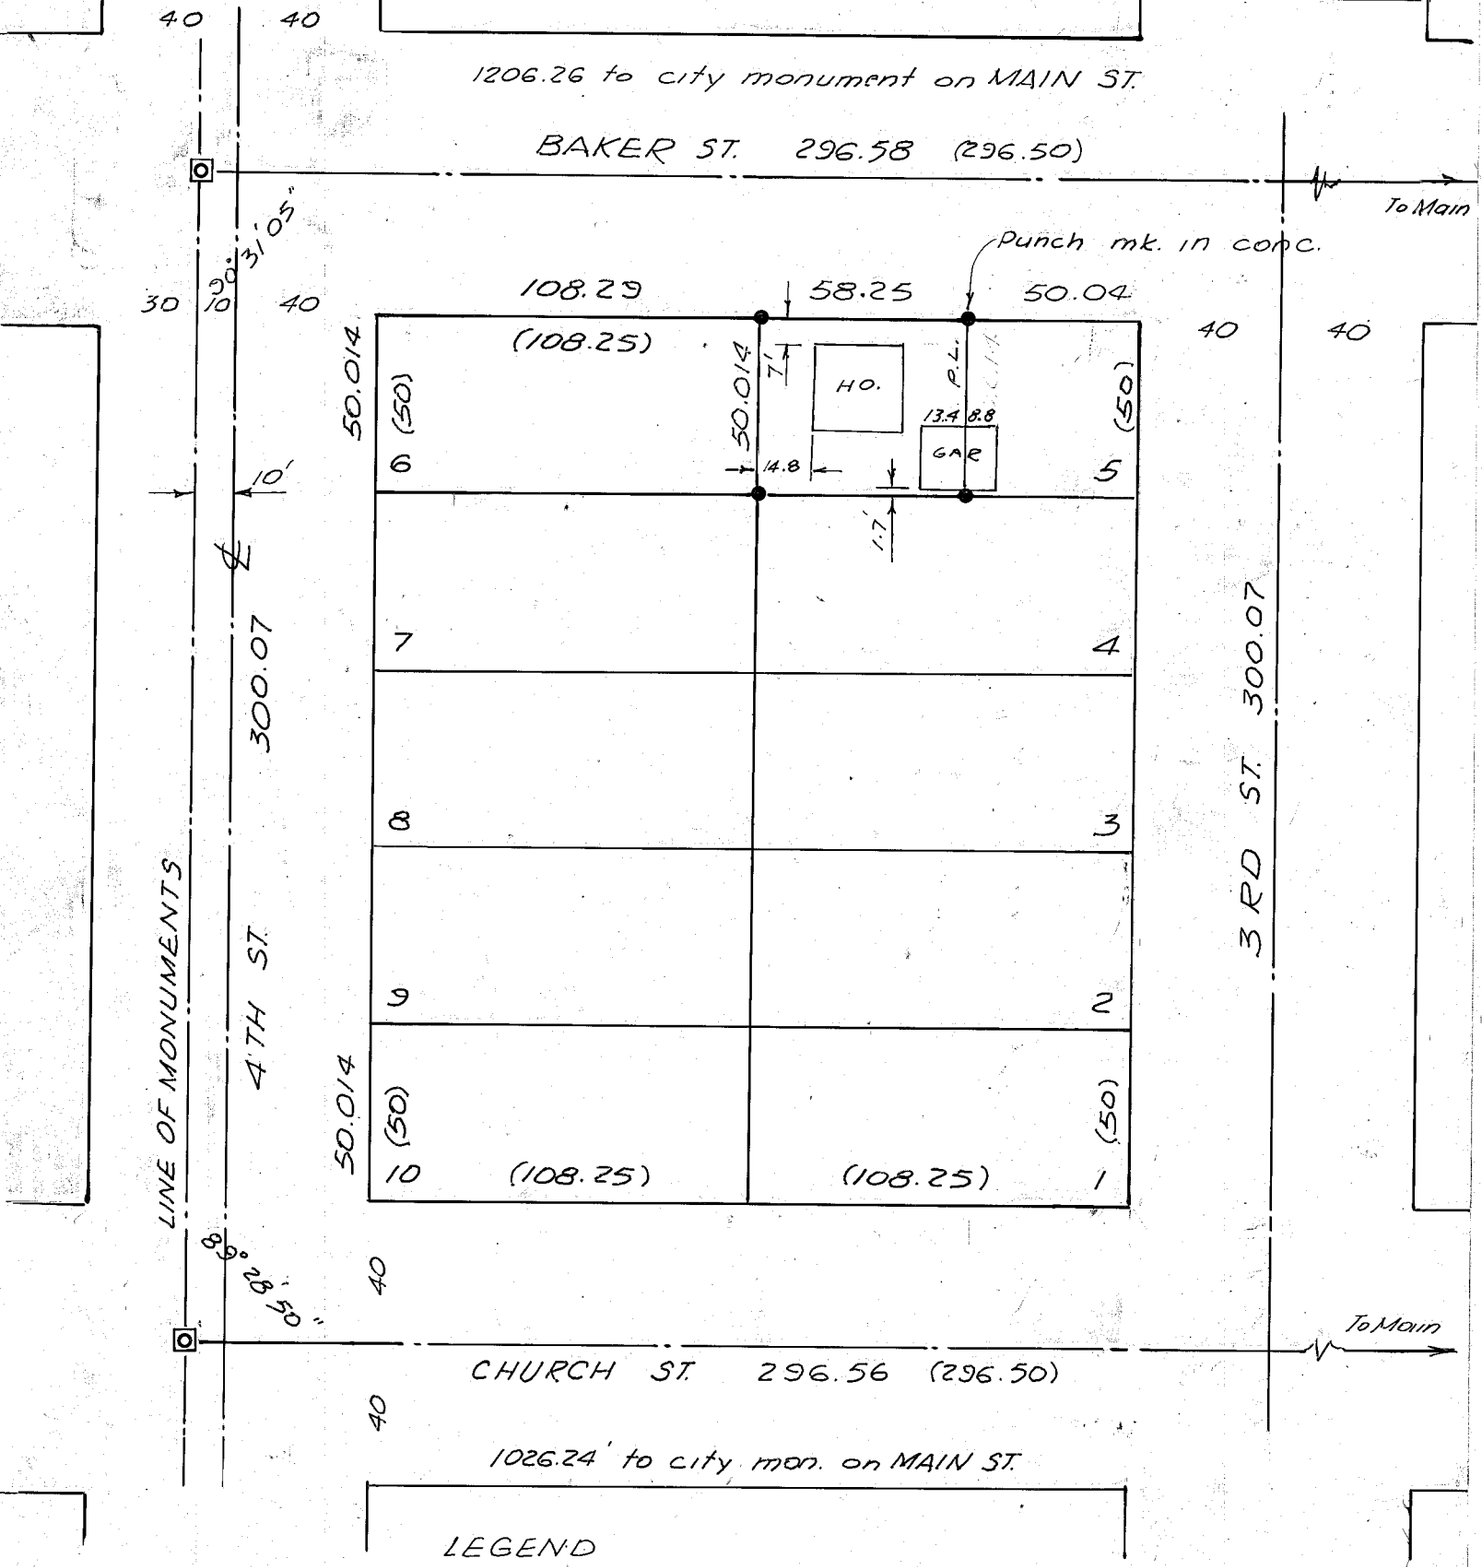

LEGEND

- ◻ Found city mon. in box
- ● Set 5/8" x 30" rebar, mkd. "HANLEY ENGR PLS 1206" in plastic cap. except as noted
- ( ) Plat record distance

MAP OF SURVEY

THE WEST 58.25 FEET OF LOT 5, BLOCK 15
J. M. BOYD'S ADDITION TO BAKER, OREGON

SURVEYED APRIL 11, 1985

For State Federal Mortgage Corporation

SCALE 1" = 50'

REGISTERED
PROFESSIONAL
LAND SURVEYOR

James D. Hanley

OREGON
SEPTEMBER 23, 1977
JAMES D. HANLEY
1206

FILED April 2 1985
BAKER COUNTY SURVEYOR
SURVEY NO. 9-40-224