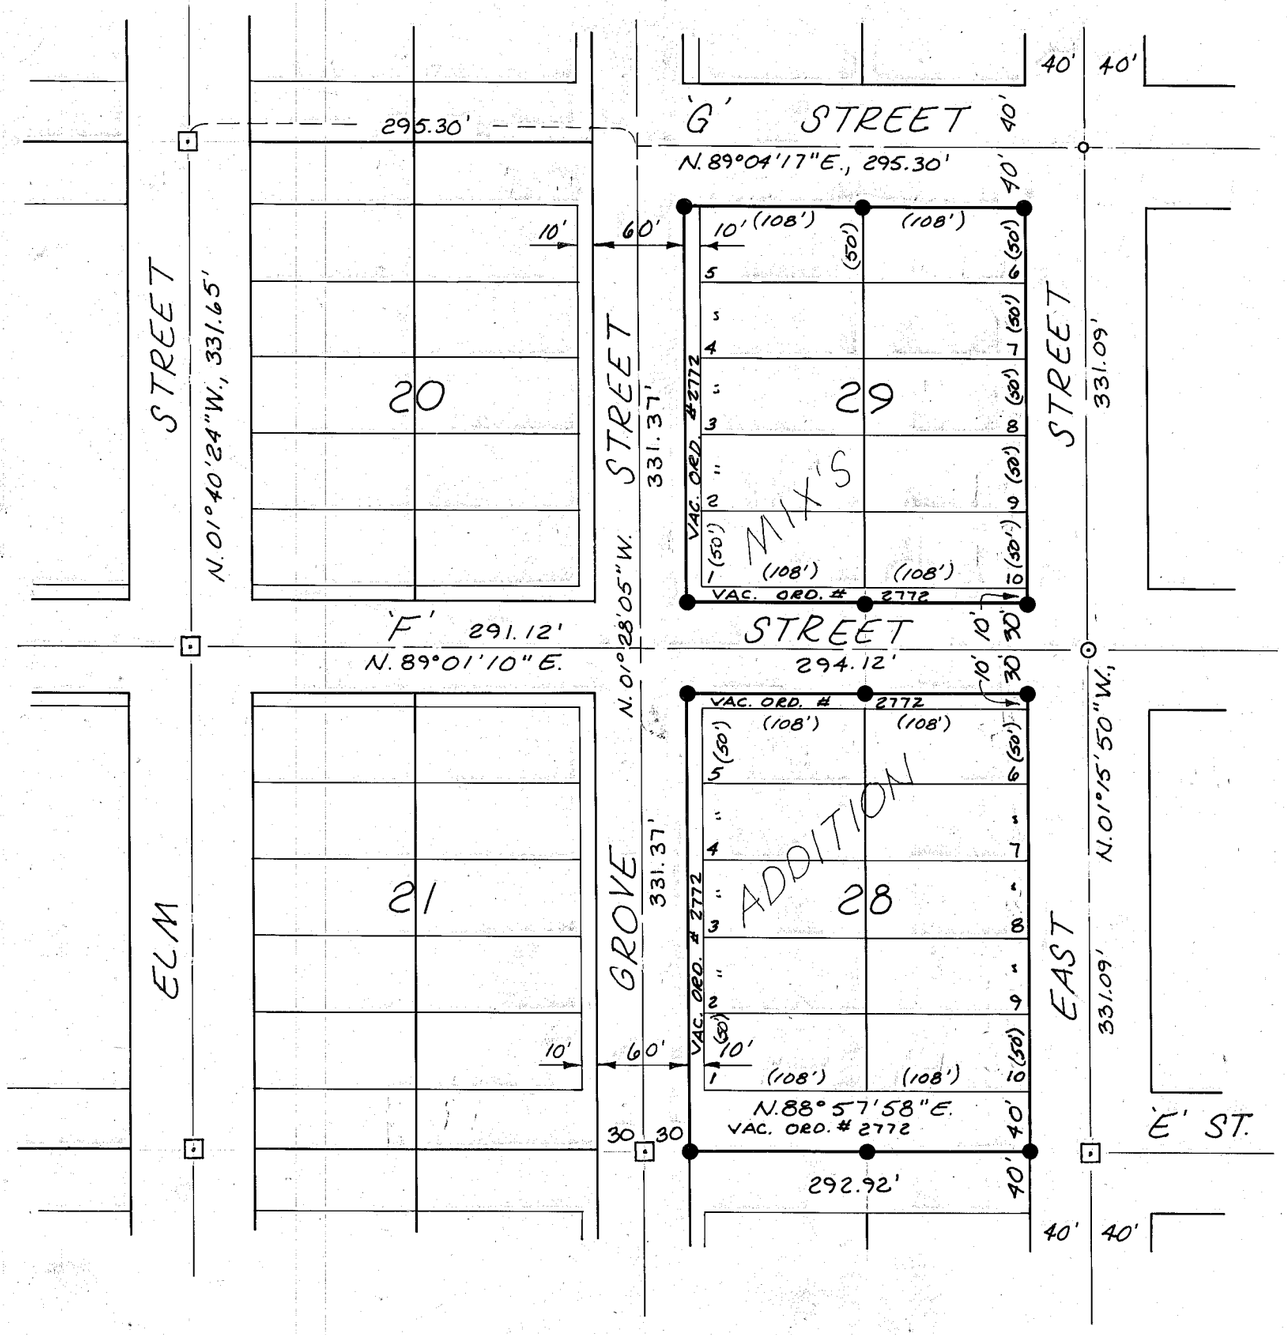

NARRATIVE

This survey for Alfred Slemp was made for the purpose of marking on the ground the corners of Blocks 28 and 29, Mix's Addition and the adjacent vacated portions of 'E' Street, 'F' Street, and Grove Streets. Monuments were found as shown hereon and survey was conducted according to standard practices.

BASIS OF BEARINGS — CITY SURVEY OF 1970

LEGEND

- ● Set 5/8" x 30" rebar w/ plastic cap mkd, 'HANLEY ENGRG PLS 1206'
- ○ Found 5/8" rebar
- ○ Found 5/8" pin
- ▣ Found city monument in box
- ( ) Record distances

MAP OF SURVEY

IN BLOCKS 28 and 29 MIX'S ADDITION
AND VACATED PORTIONS OF
'E' STREET, 'F' STREET and
GROVE STREET

SURVEYED APRIL 20 and MAY 27, 1988

FOR

ALFRED SLEMP

SCALE: 1"=100'

REGISTERED PROFESSIONAL LAND SURVEYOR
James D. Hanley
OREGON
SEPTEMBER 23, 1977
JAMES D. HANLEY
1206

HANLEY ENGINEERING
BAKER, OREGON

FILED June 15, 1988
BAKER COUNTY SURVEYOR
SURVEY NO. 9-40-265