


MAIN STREET MONUMENTS

LEGEND

- Pk. nail
- Ac nail & flasher
- Hub & tack
- △ Ser. # 5 x 30" rebar with yellow cap marked CITY OF BAKER PLS 2162
- Point as described

Existing monument before construction

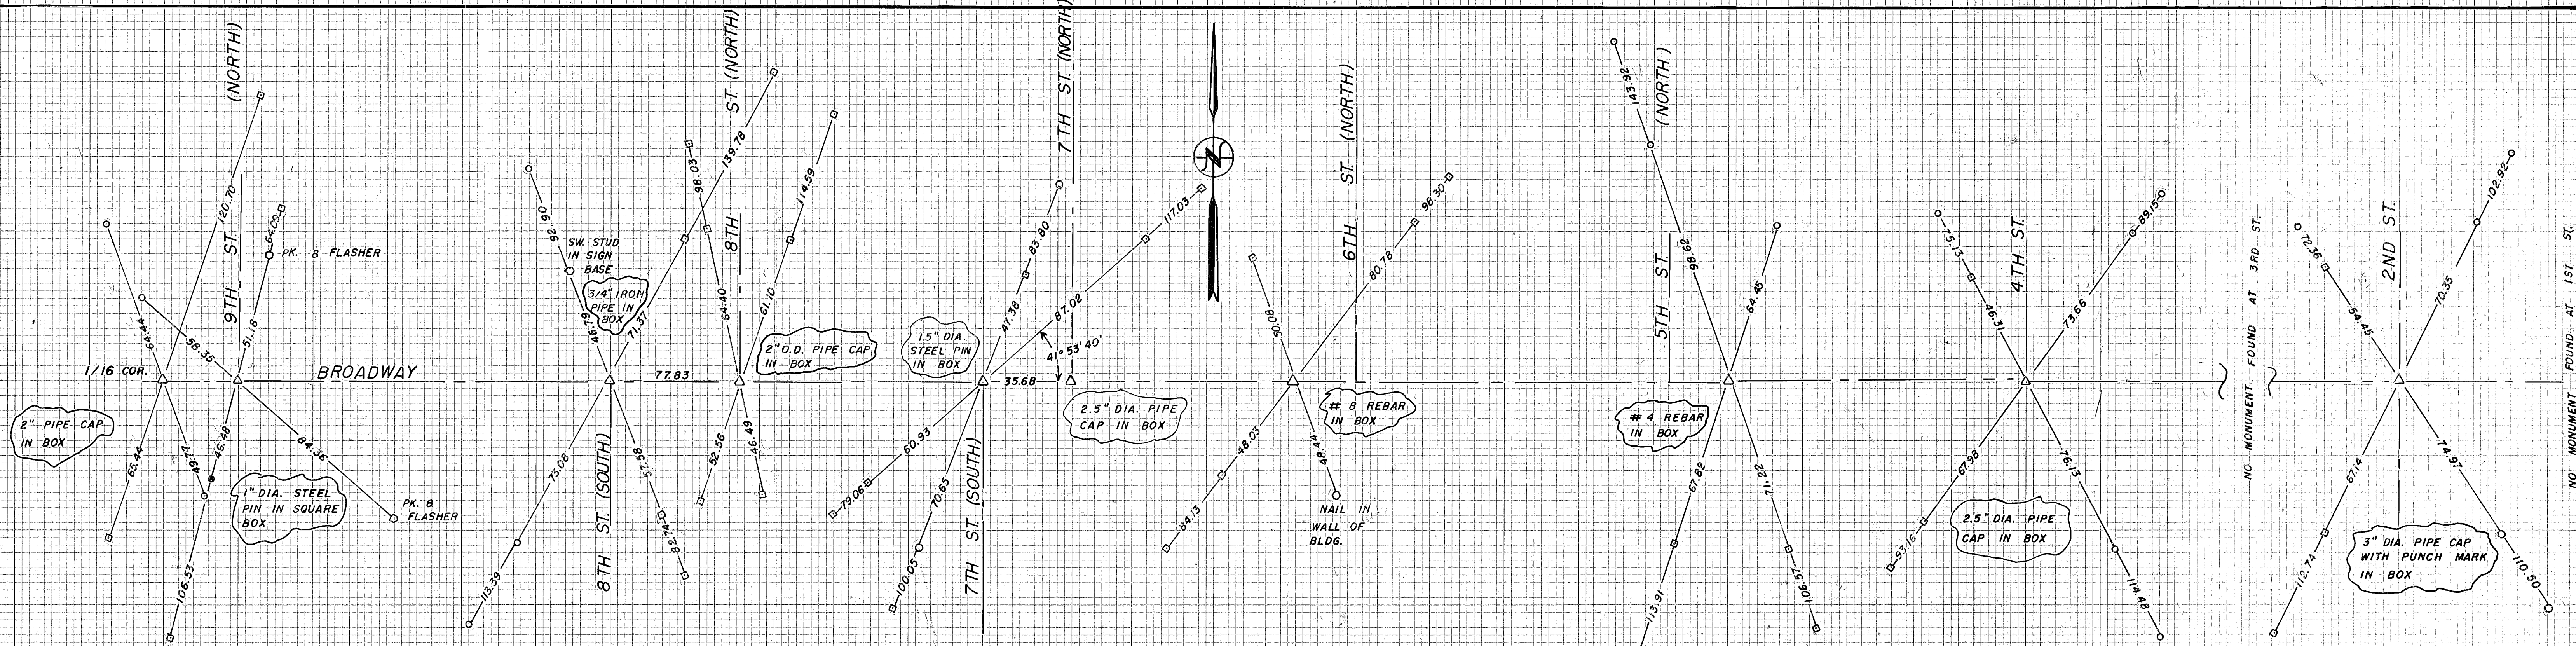

BROADWAY STREET MONUMENTS

COMMENTS

This survey was made at the request of the Oregon Department of Transportation. It preserves the chain of evidence for the existing monuments removed during street construction. Although these are all generally accepted control points, this survey in no way makes any judgement to their origin or meaning.

REGISTERED PROFESSIONAL LAND SURVEYOR
Gary Van Patten
 OREGON
 JULY 26, 1985
 GARY VAN PATTEN
 2162

FILED 8-29-88
 BAKER COUNTY SURVEYOR
 SURVEY NO. 9-40-272

CITY OF BAKER, OREGON
OFFICE OF TECHNICAL SERVICES

**MAIN ST. & BROADWAY ST.
MONUMENT
REFERENCES & REPLACEMENT**

| | |
|-----------------------|---------------------------------|
| DRAWN <u>G.V.P.</u> | APPROVED _____ City Engineer |
| CHECKED _____ | APPROVED _____ City Manager |
| SCALE <u>N.T.S.</u> | |
| DATE <u>AUG. 1988</u> | |

SHEET 1 OF 1 SHEETS