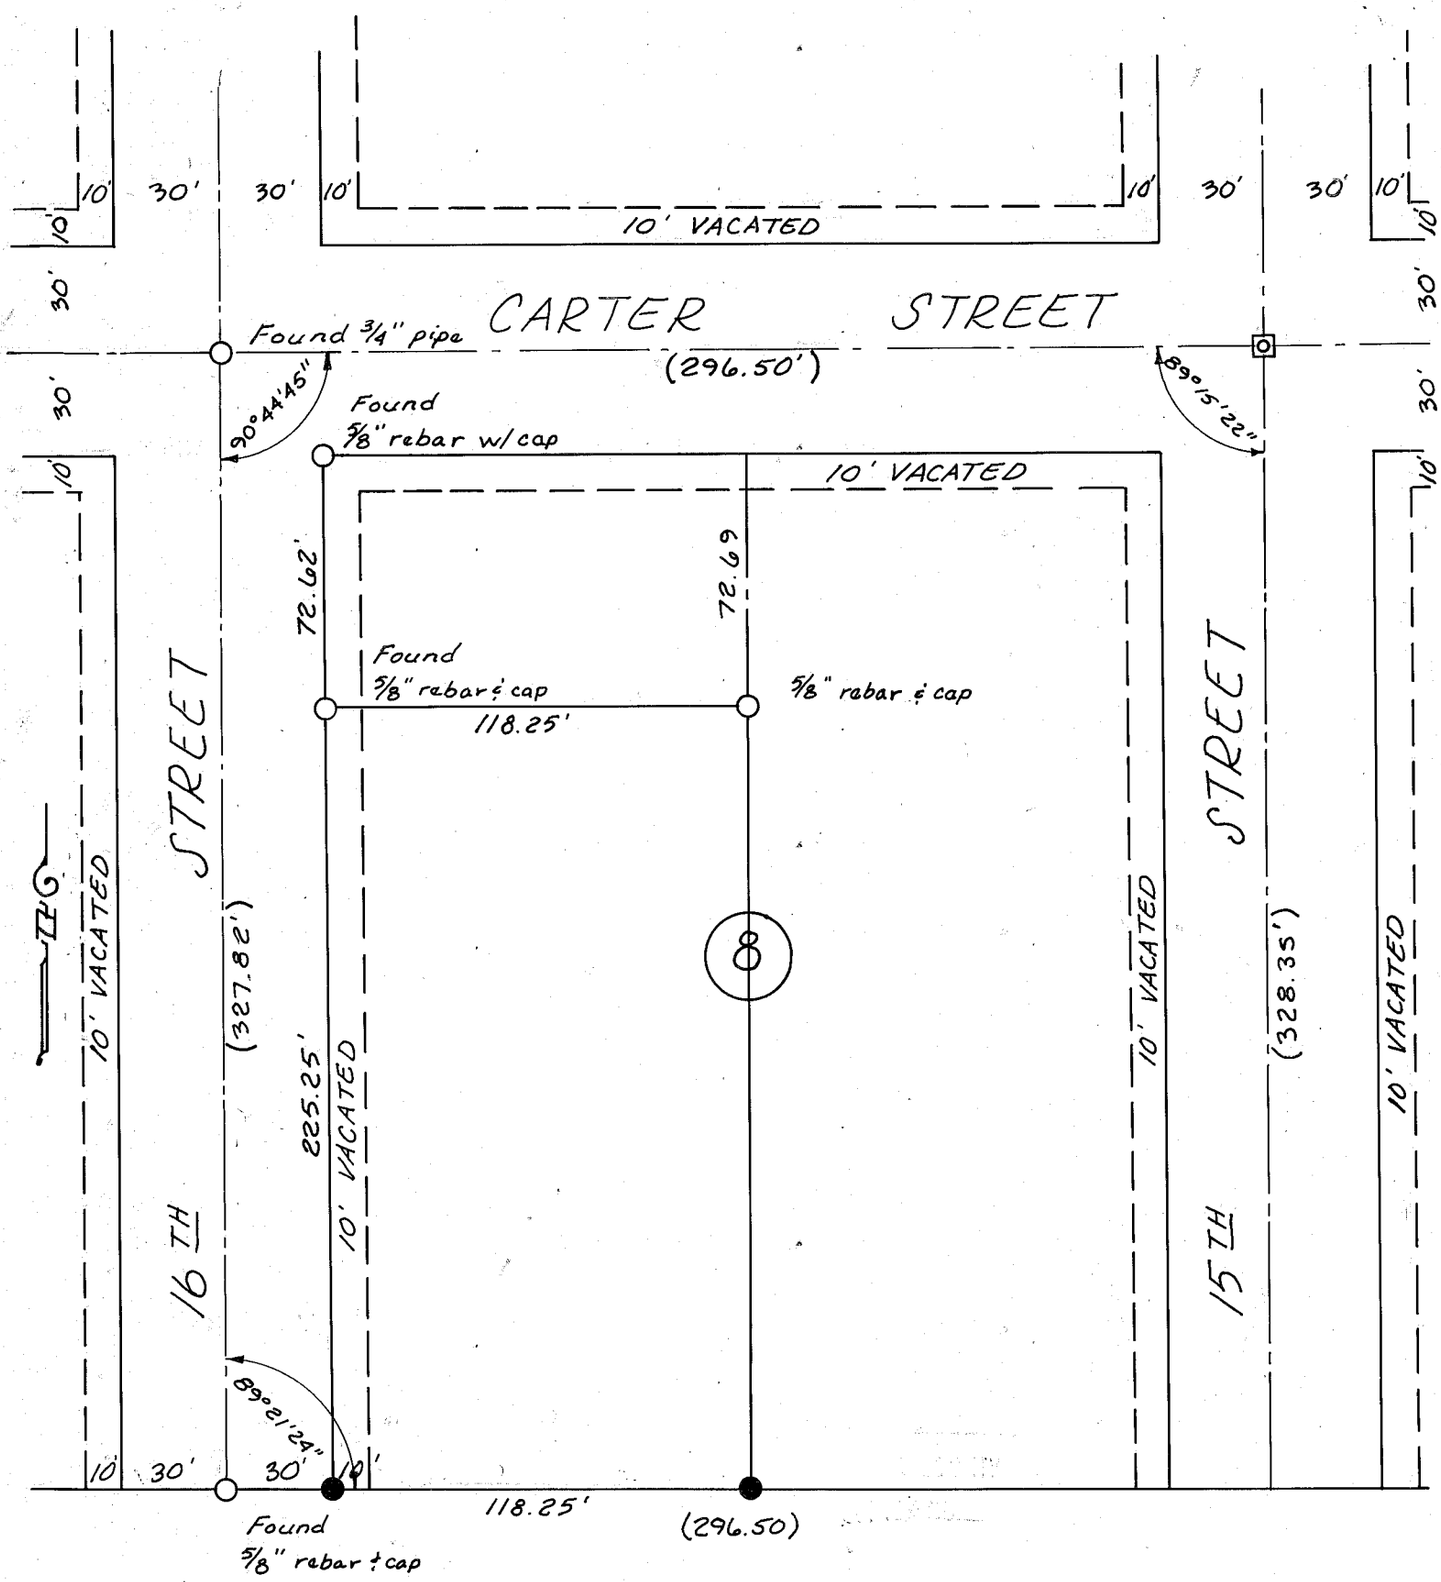

MAP OF SURVEY

A PARCEL IN BLOCK 8, KELLOG'S ADDITION

BAKER, OREGON

SURVEYED FOR BOB BLUM NOV. 11, 1988

SCALE: 1"=50'

SURVEY REF. NO.: 9-40-216

LEGEND

- ○ Found monument as noted
- ● Set 5/8" x 30" rebar marked "HANLEY ENGR. PLS 1206"
- ⊡ Found city mon. in box
- ( ) Record distance, Survey No. 9-40-216

FILED Dec. 28, 1988
BAKER COUNTY SURVEYOR
SURVEY NO. 9-40-278

REGISTERED PROFESSIONAL LAND SURVEYOR

James D. Hanley

OREGON
SEPTEMBER 23, 1977
JAMES D. HANLEY
1206

BAKER, OREGON