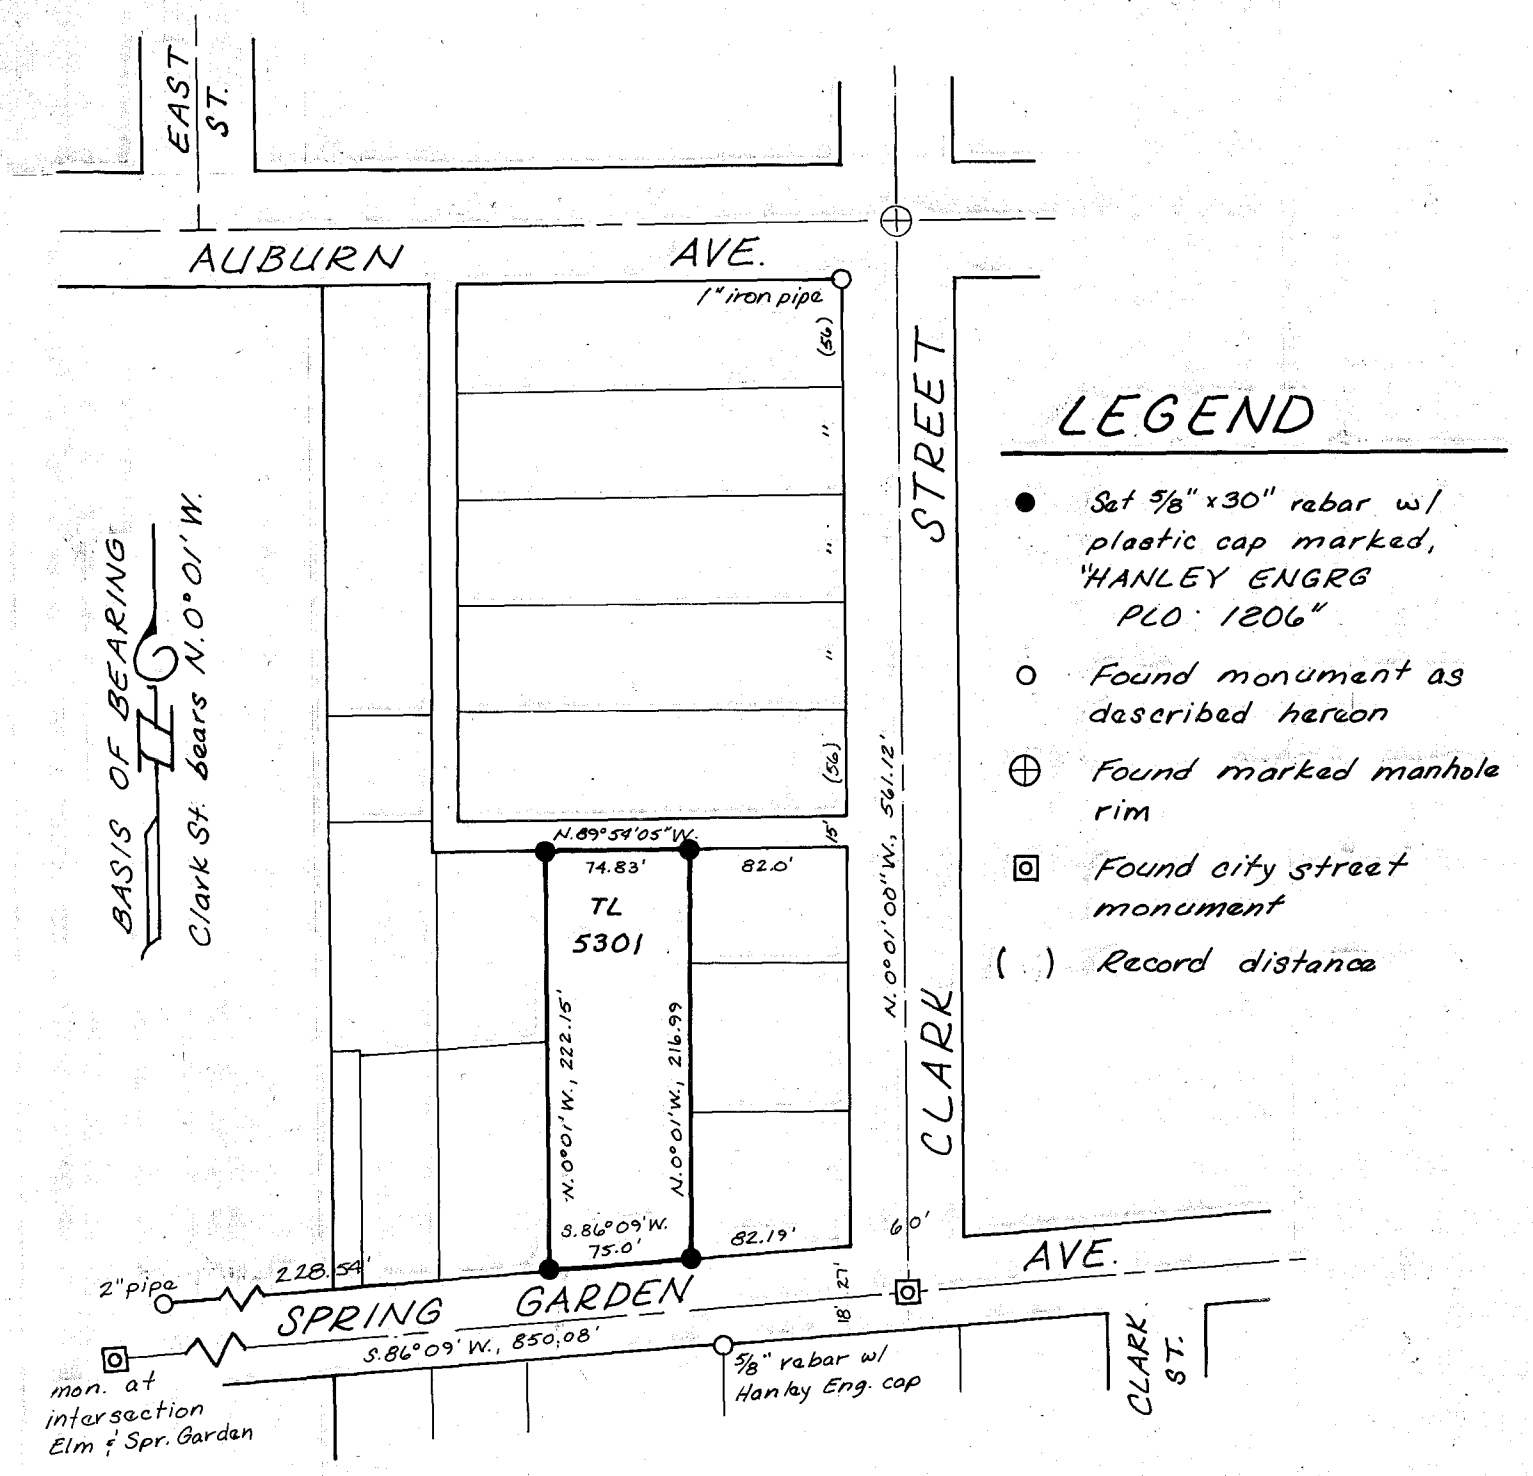

LEGEND

- ● Set 5/8" x 30" rebar w/ plastic cap marked, "HANLEY ENGRG PLO 1206"
- ○ Found monument as described hereon
- ⊕ Found marked manhole rim
- ▣ Found city street monument
- ( ) Record distance

NARRATIVE

This survey for Lloyd Nelson was made for the purpose of marking on the ground the parcel shown hereon. Monuments were recovered as shown hereon and survey proceeded following standard practices.

MAP OF SURVEY

A PARCEL IN THE NW¼NE¼
SECTION 21, T. 9S., R. 40E.,
W.M.
BAKER, OREGON

SURVEYED: SEPTEMBER 12 & 13, 1989

FOR

LLOYD NELSON

SCALE: 1"=100'

REGISTERED PROFESSIONAL LAND SURVEYOR
OREGON
SEPTEMBER 23, 1977
JAMES D. HANLEY
1206

HANLEY ENGINEERING
BAKER, OREGON

FILED 10-18-89
BAKER COUNTY SURVEYOR
SURVEY NO. 9-40-292