
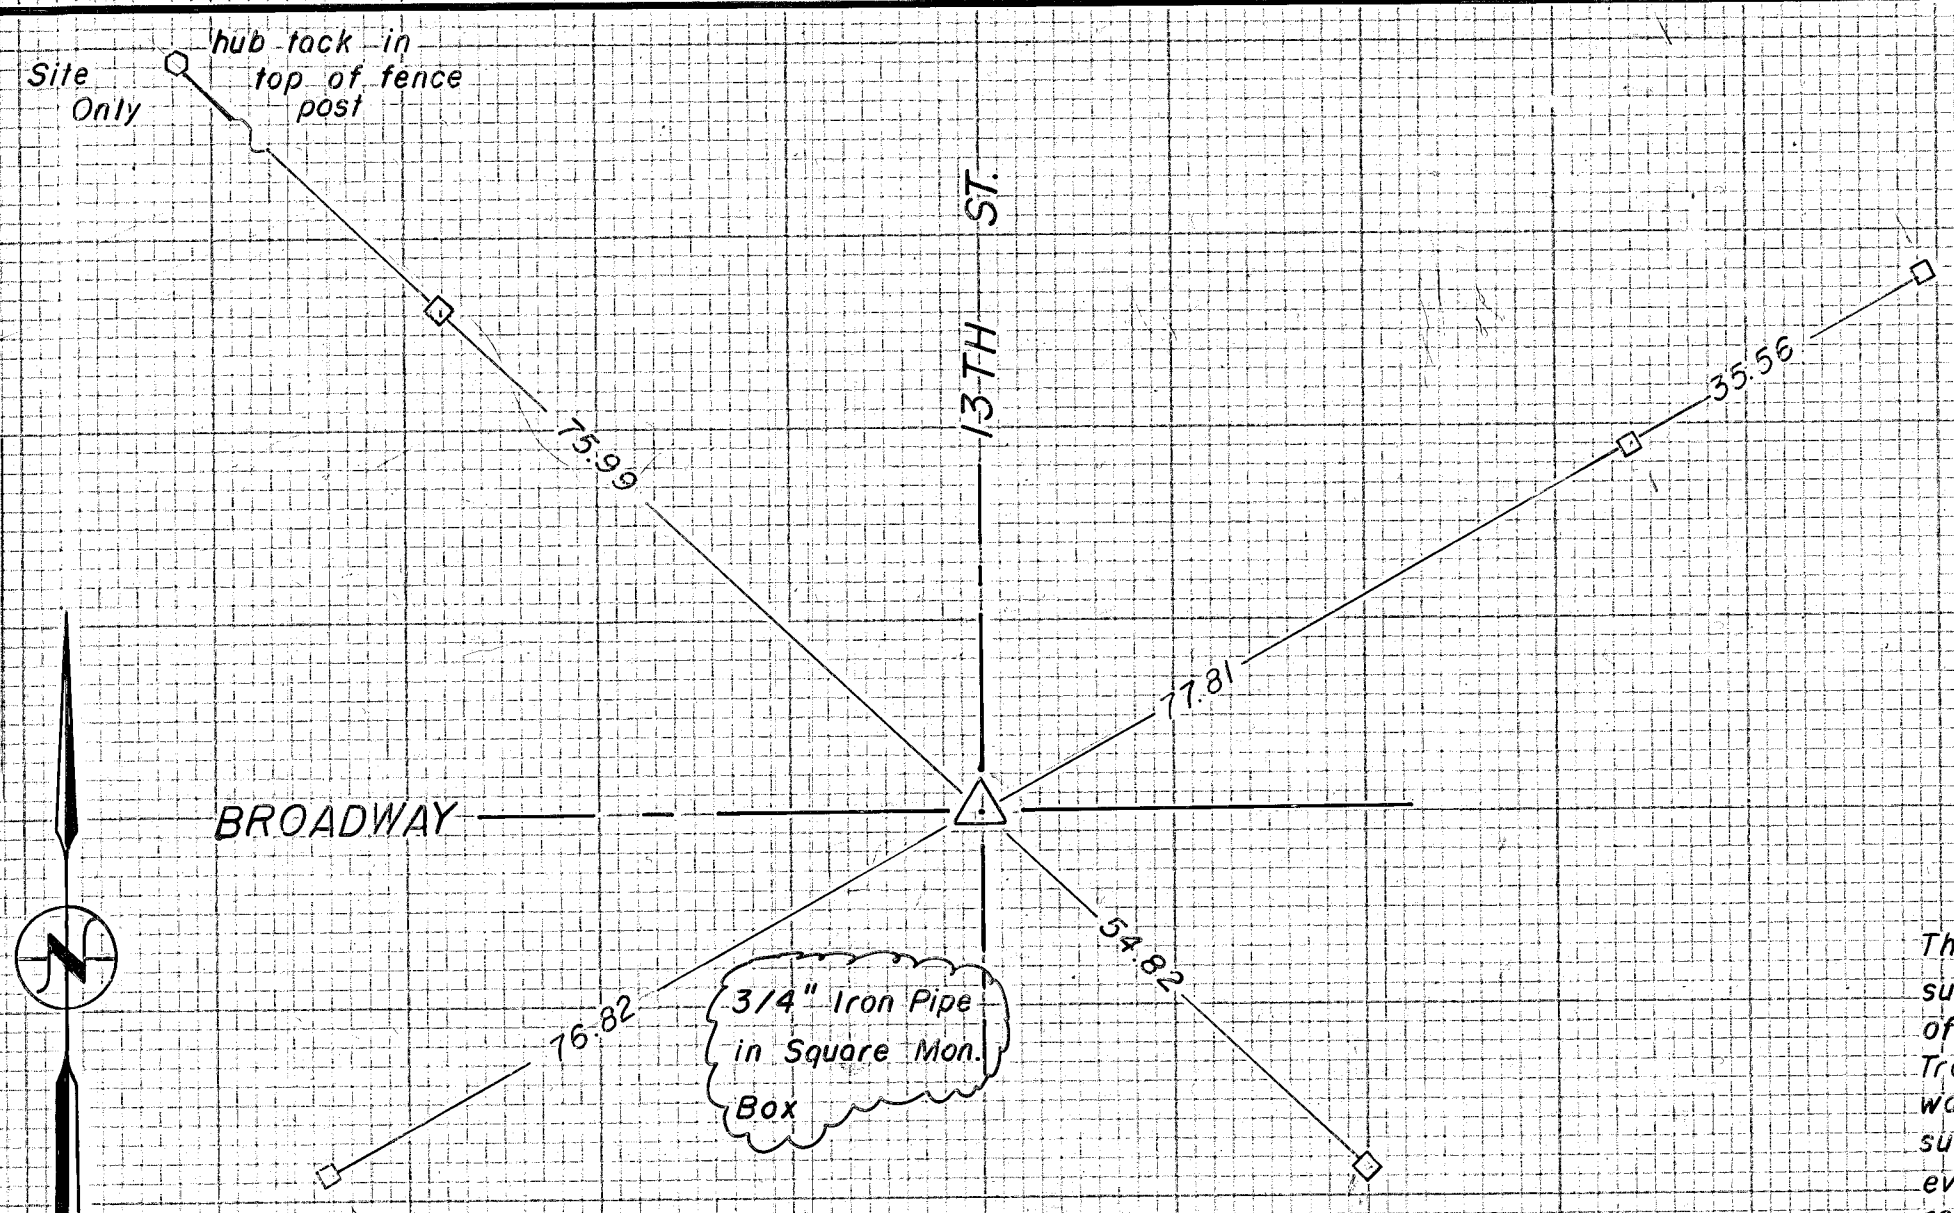


AUBURN AVE.

MAIN ST.

RESORT ST.

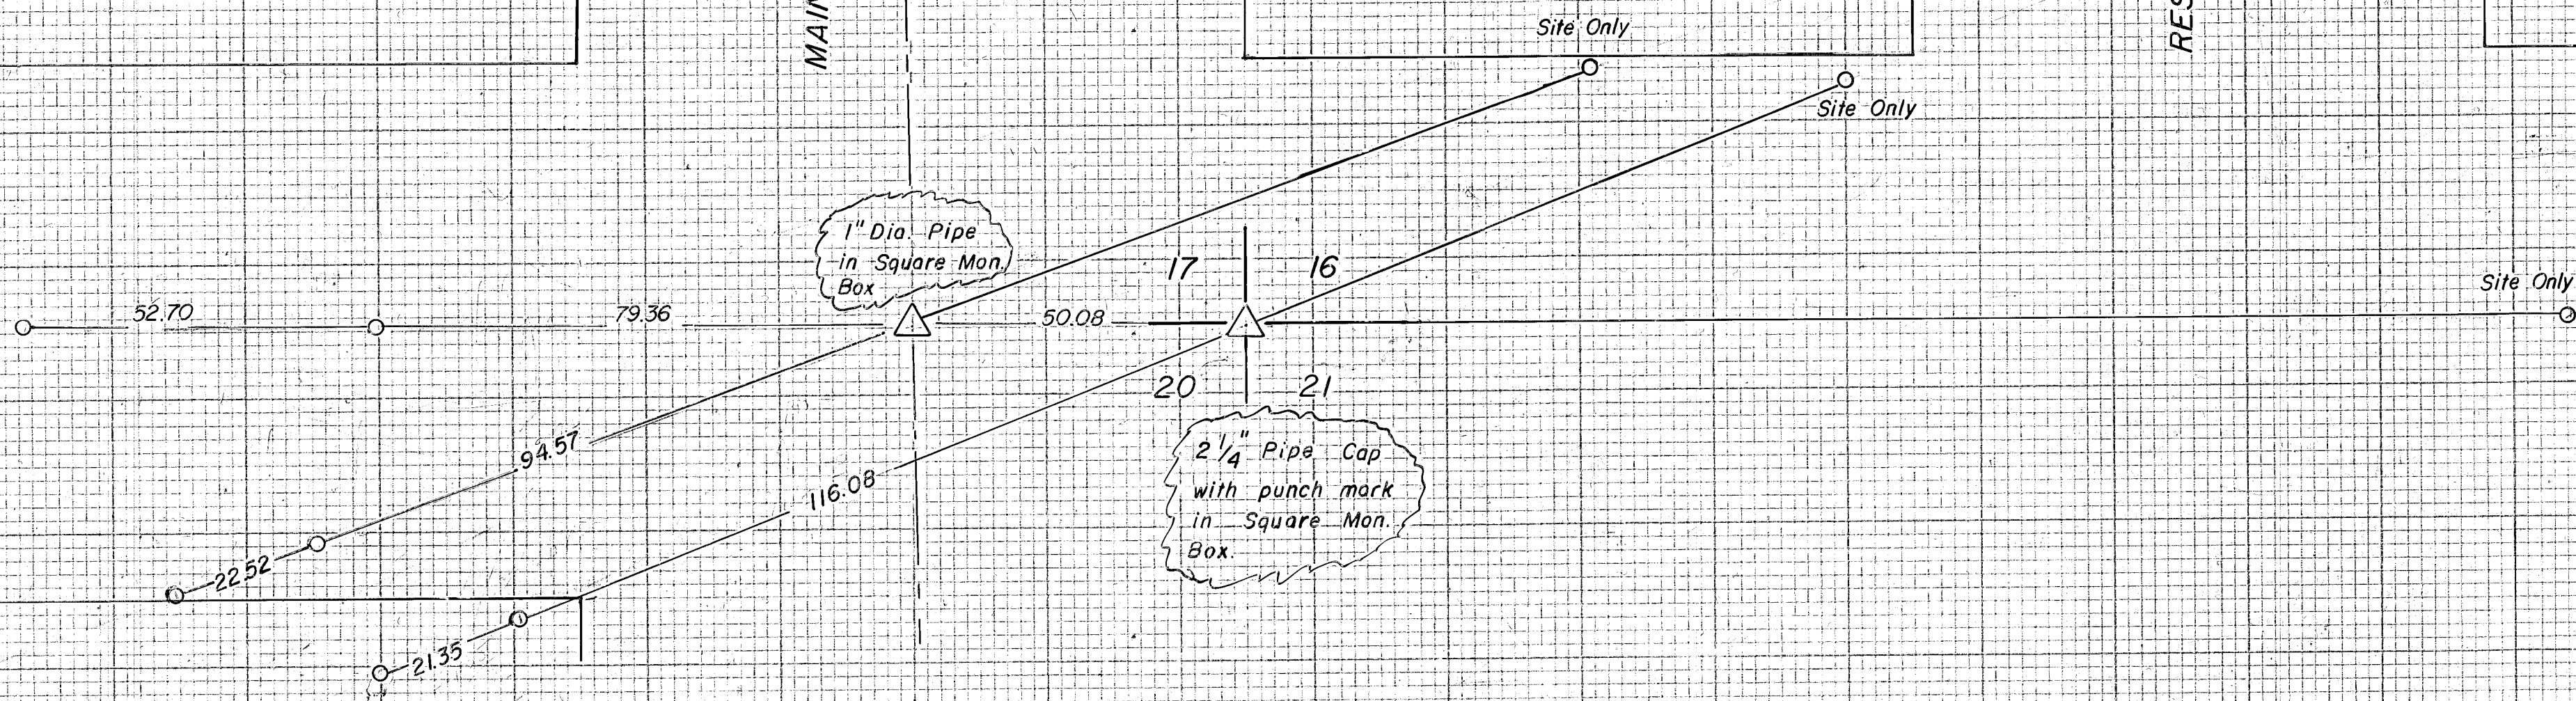

Legend

- AC Nail and Flasher
- Hub and Tack
- △ Set #5 x 30" rebar with yellow cap marked CITY OF BAKER PLS 2162
- Existing monument before construction

COMENTS

The Main Street portion of this survey was made at the request of the Oregon Department of Transportation. The Broadway portion was done for the City. This survey preserves the chain of evidence for the existing monuments removed during street construction. Although these are all generally accepted control points, this survey in no way makes any judgement to their origin or meaning.

REGISTERED PROFESSIONAL LAND SURVEYOR
Gary Van Patten
 OREGON
 JULY 26, 1985
 GARY VAN PATTEN
 2162

FILED Nov. 17, 1989
 BAKER COUNTY SURVEYOR
 SURVEY NO. 9-40-293

BAKER CITY, OREGON
 OFFICE OF TECHNICAL SERVICES
 POST OFFICE SQUARE
 8
 BROADWAY AND 13TH ST.
 MONUMENT REFERENCES

DRAWN G.V.P. APPROVED City Engineer
 CHECKED APPROVED City Manager
 SCALE n.f.s.
 DATE Nov. 1989 SHEET 11 OF 1 SHEETS