


# NARRATIVE

The purpose of this survey for Northwest Properties, Inc. was to mark on the ground the property corners of a parcel of ground described in Deed No. 89 18 20 and including a portion of Block 6 and vacated 11th Street in John Stewarts Addition. Original centerline monumentation along 10th Street was destroyed around 1960 and thus other existing monumentation and dimensions from the city Engineer's "Bailey Map" were employed to reestablish the street lines as close as now possible to their original locations.

## LEGEND

- ◻ City monument in box
- Found monument of record
- Set 5/8" x 30" rebar with plastic cap
- [ ] Record distance from City Engineers "Bailey Map"

SCALE: 1" = 100'

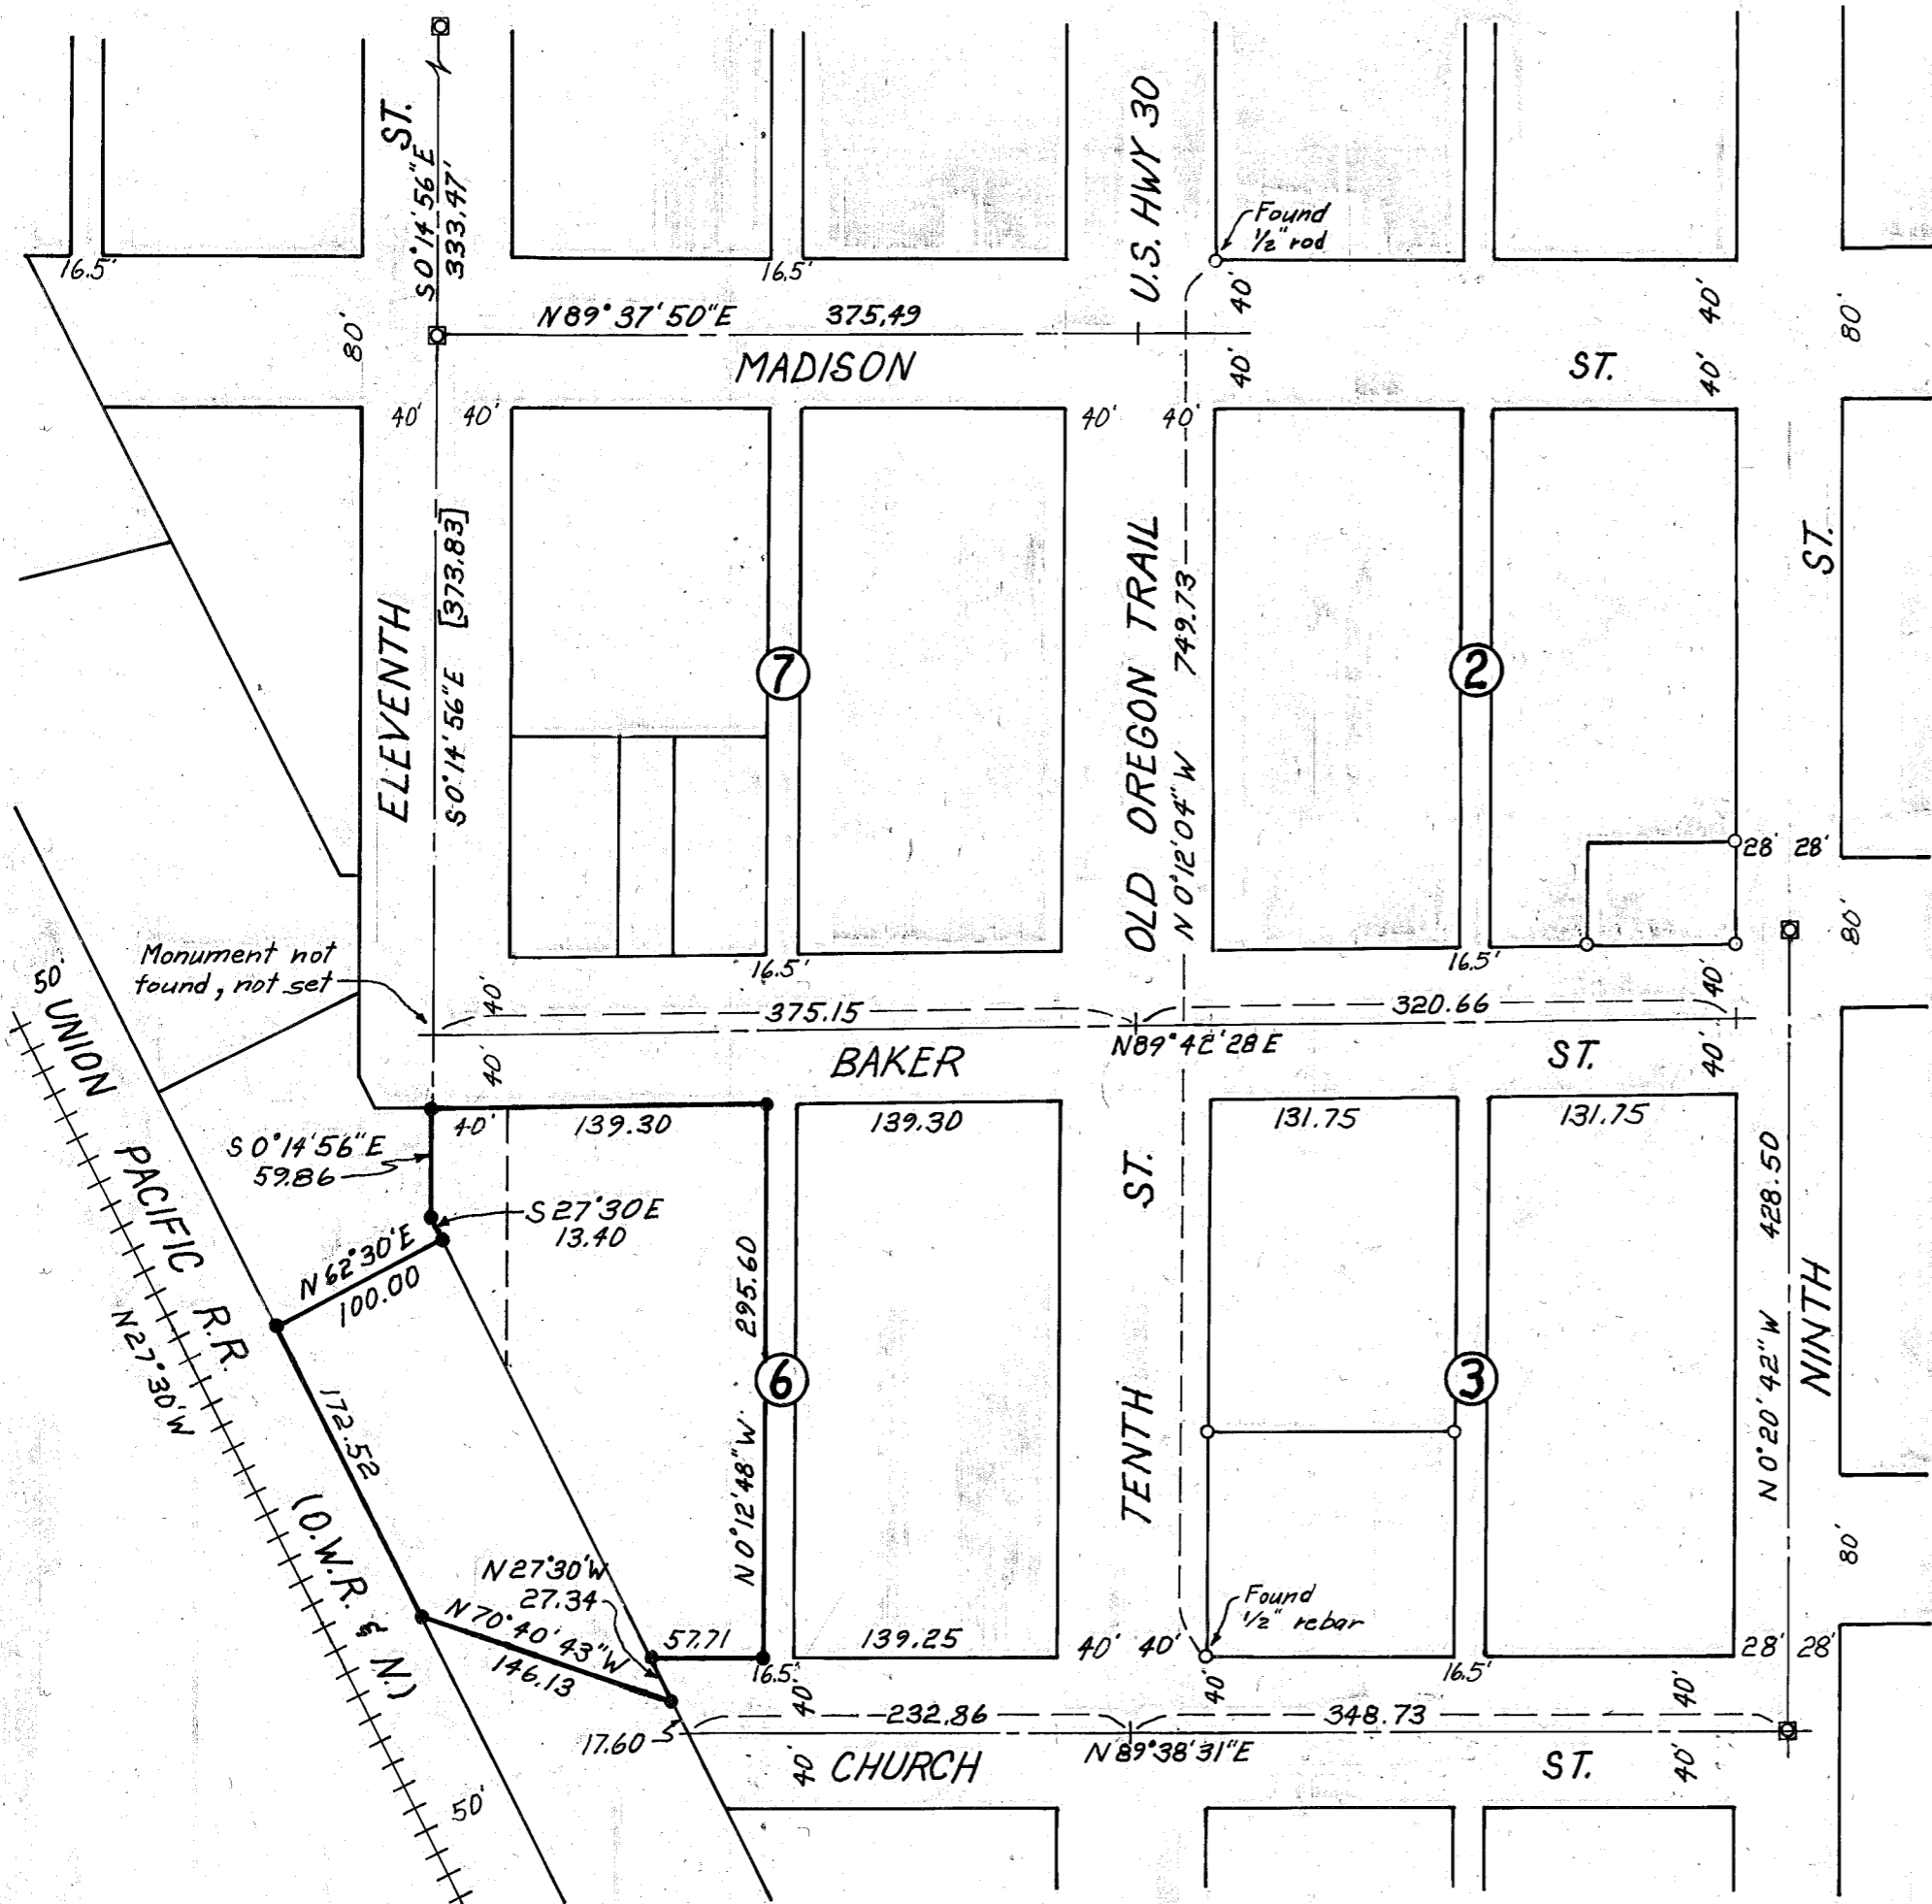

REGISTERED  
PROFESSIONAL  
LAND SURVEYOR

*James D. Hanley*

OREGON  
SEPTEMBER 23, 1977  
JAMES D. HANLEY  
1206

Surveyed June 1990

HANLEY ENGINEERING  
BAKER CITY, OREGON

FILED July 27, 1990  
BAKER COUNTY SURVEYOR  
SURVEY NO. 9-40-311