

LEGEND


- SET 5/8" x 30" REBAR WITH PLASTIC CAP
- () ORIGINAL PLAT DISTANCE

NARRATIVE: THE PURPOSE OF THIS SURVEY FOR SAM LAY IS TO MARK ON THE GROUND THE CORNERS OF THE PARCEL SHOWN HEREON. CORNER MONUMENTS WERE RECOVERED, INFORMATION FROM SURVEY NO. 9-40-191 WAS VERIFIED AND USED FOR THIS SURVEY.


**MAP OF SURVEY
 LOTS 4, 5, AND 6, BLOCK 36
 PACIFIC ADDITION TO BAKER CITY, OREGON**

SURVEYED MAY 28, 1991
 HANLEY ENGINEERING, BAKER CITY, OREGON

SCALE 1" = 50'

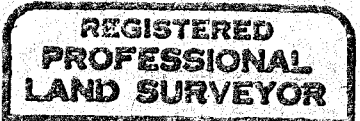

Thomas D. Fisk

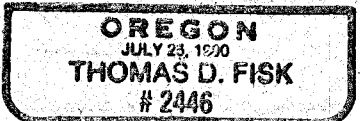

FILED JUNE 10, 1991
 BAKER COUNTY SURVEYOR
 SURVEY NO. 9-40-339