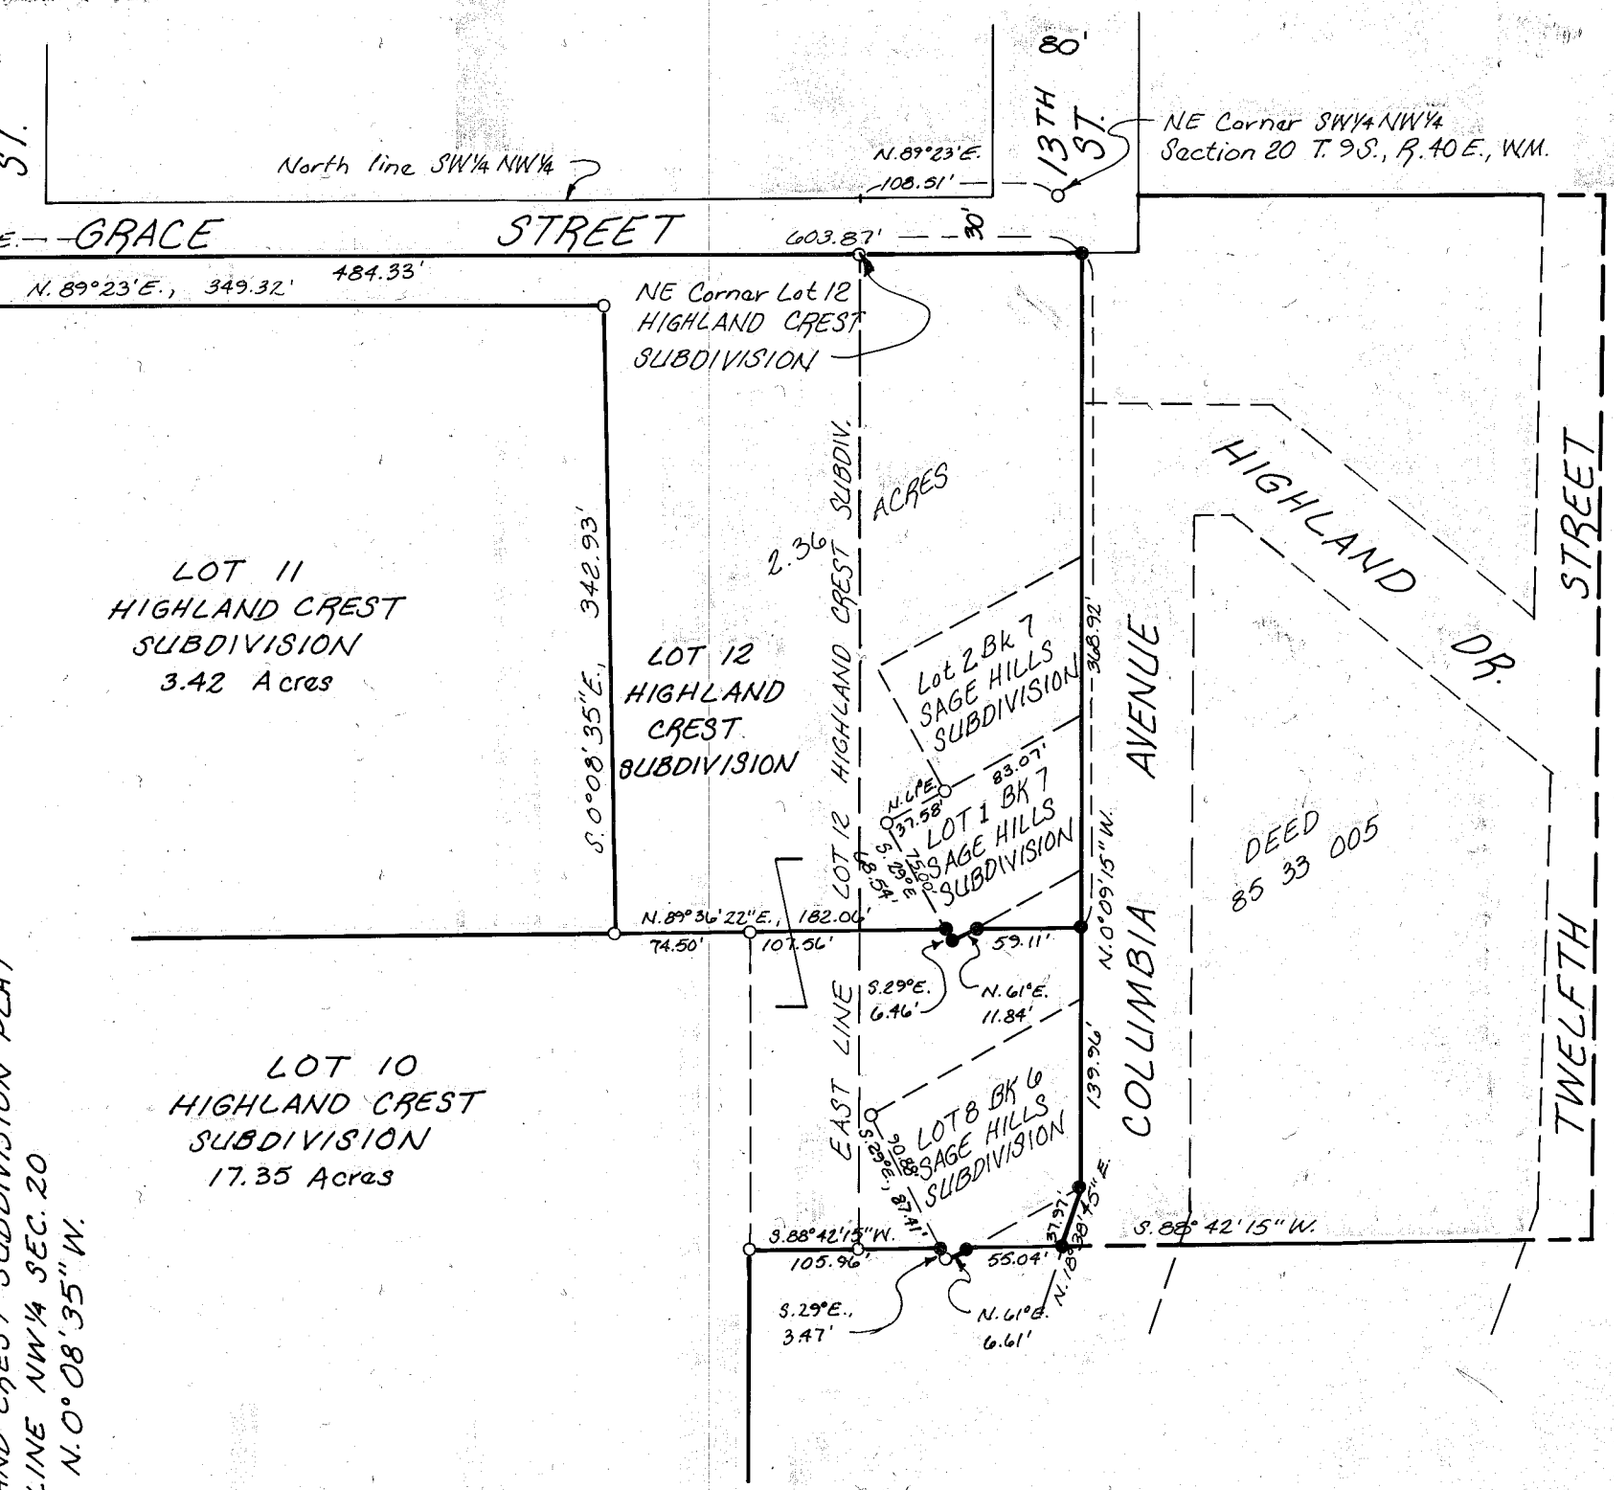

SURVEY NARRATIVE

The purpose of this property line adjustment surv
Jeff Petry is to adjust the South and East bounda
Lot 12, Highland Crest Subdivision and the Easter
ary of Lot 10, Highland Crest Subdivision as shown
Monumentation from Highland Crest Subdivision Pl
Sage Hills Subdivision Phase I was recovered ar
bearings and distance used for the location of Co
Avenue.

LEGEND

- ○ —— Found Monument of record HIGHLAND C
DIVISION PLAT or SAGE HILLS SUBDIV
- ● —— Set 5/8" x 30" rebar w/ plastic cap marke
ENGR. PLS 1206"

PROPERTY LINE ADJUSTMENT SURVEY

IN THE SW¼ NW¼ SECTION 20

T. 9 S., R. 40 E., W.M.

For Jeff Petry

May 18, 1993

Scale: 1" = 100'

REGISTER
PROFESSIO
LAND SURV
James D. A
OREGO
SEPTEMBER 23,
JAMES D. HA
1206

FILED May 20 1993
BAKER COUNTY SURVEYOR
SURVEY NO. 9-40-370