


5-28-84

BASIS OF BRNG 5TH ST centerline between monuments on MYRTLE ST. and GRACE ST. assumed North.

West half Block 46 staked according to descriptions furnished by local title company of Dale Hoopes instructions

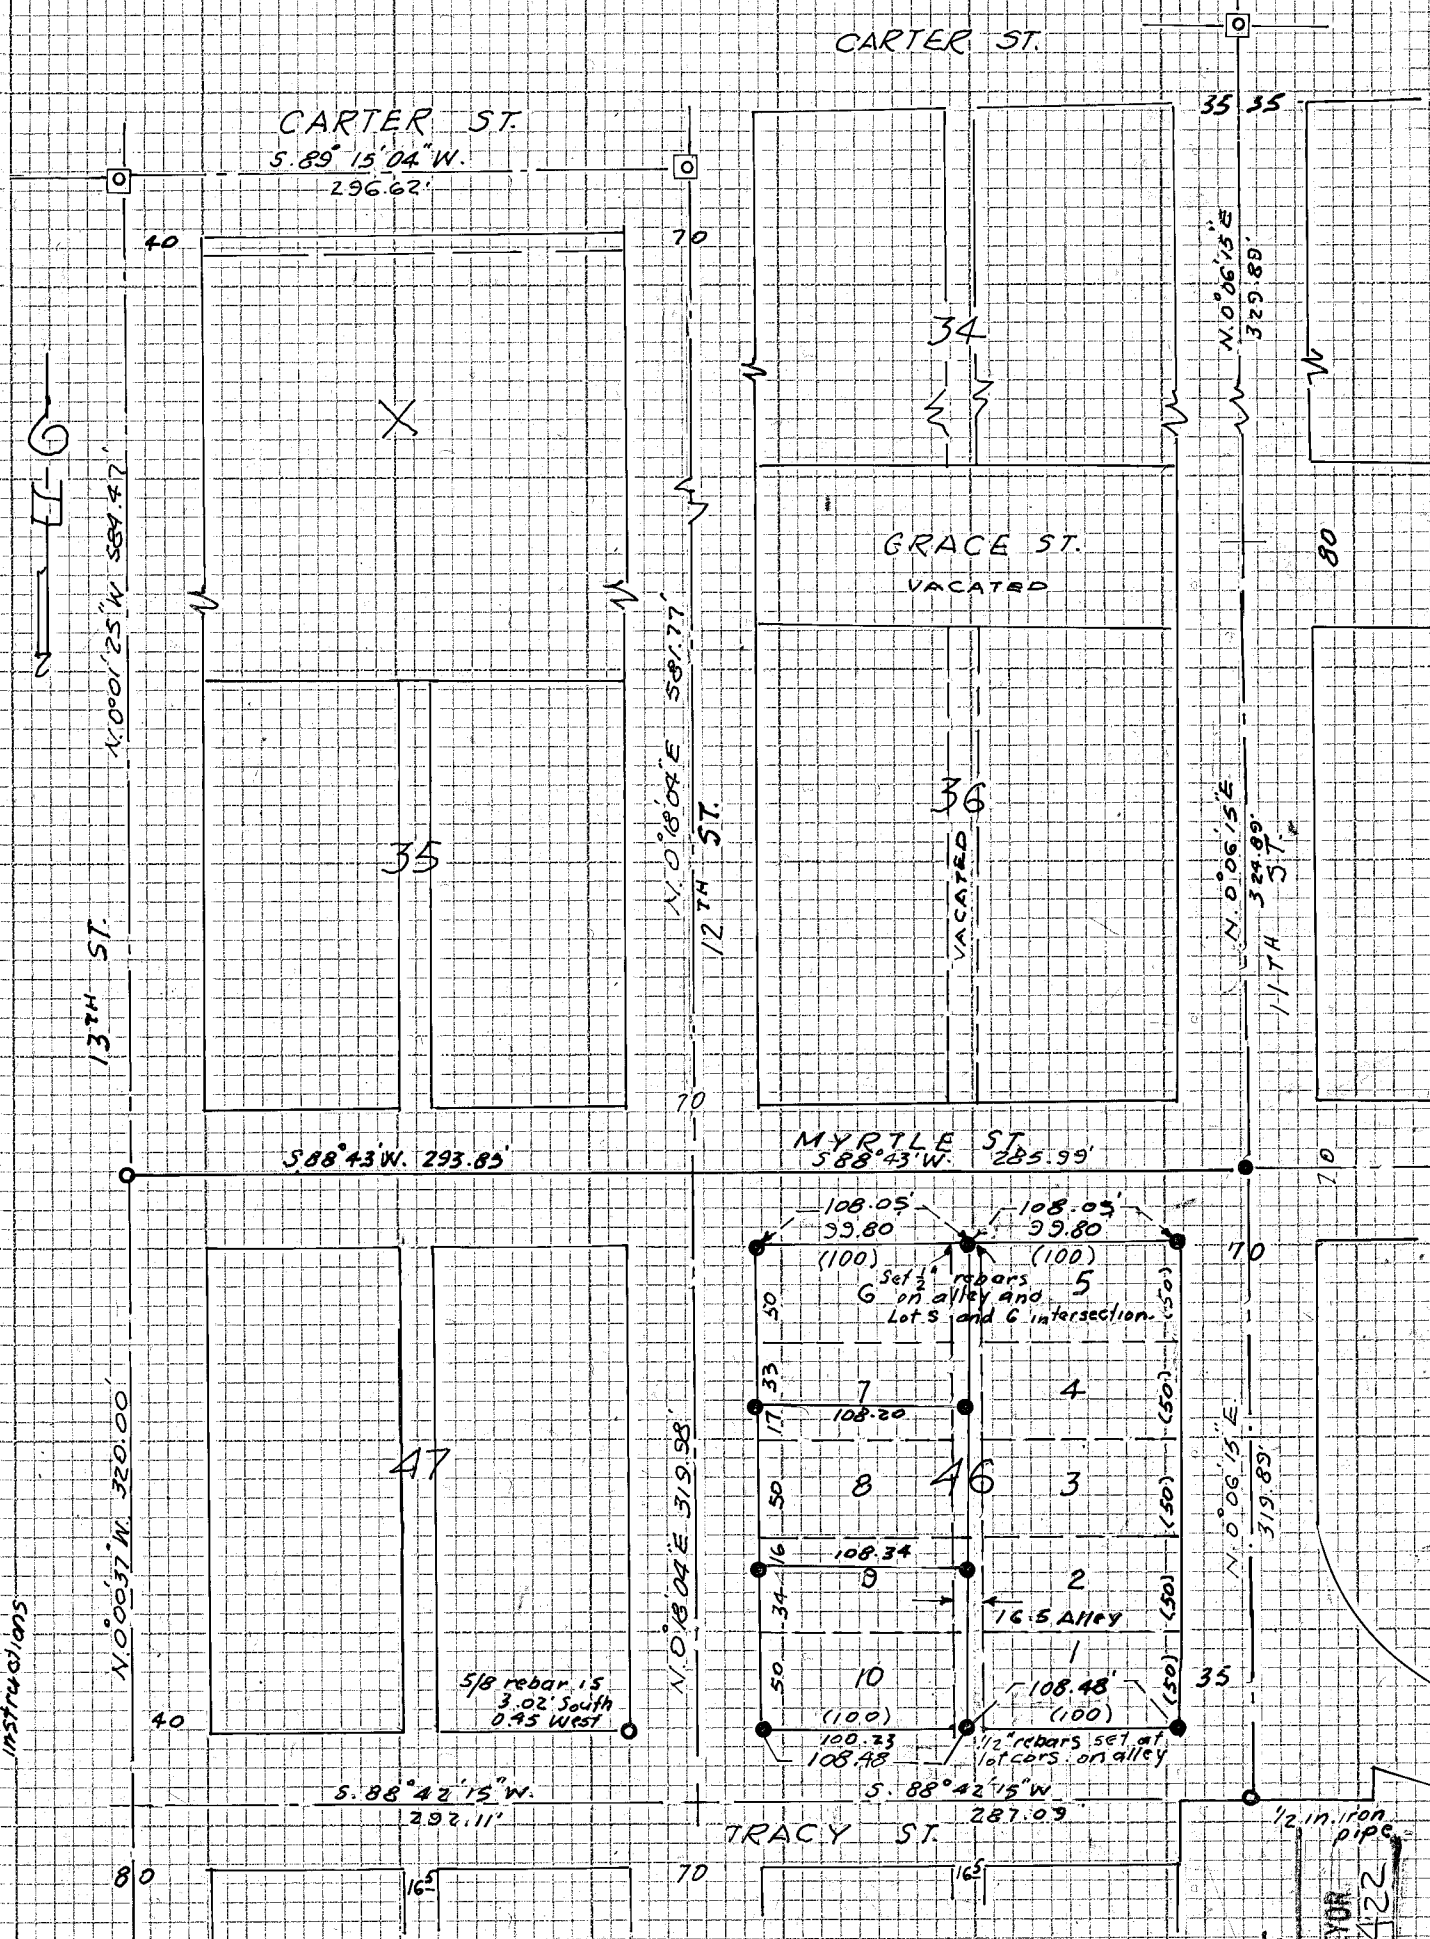

**MAP OF SURVEY**  
 IN BLOCK 46, McCRARY ADDITION  
 TO BAKER, OREGON

MAY 21, 1984

1" = 100'

FOR DALE HOOPES

LEGEND

- ⊠ Fnd. City pin in steel man. box
- Fnd. object as noted
- Set 5/8" x 30" rebar with plastic cap mkd. PL51206
- ( ) Orig. plat distances

REGISTERED  
 PROFESSIONAL  
 LAND SURVEYOR

James D. Hanley  
 OREGON  
 SEPTEMBER 23, 1977  
 JAMES D. HANLEY  
 1206

FILED 12-15-85  
 BAKER COUNTY SURVEYOR  
 SURVEY NO. 2-40-42

S. 0° 00' 37" E 707.69'  
 to alum. cap mon. on  
 N. line Indiana Street

N. 0° 00' 37" W. 320.00'

13TH ST.

N. 0° 01' 25" W. 584.47'

CARTER ST.  
 S. 89° 15' 04" W.  
 296.62'

N. 0° 18' 04" E 581.77'

12TH ST.

CARTER ST.

GRACE ST.  
VACATED

MYRTLE ST.  
 S. 88° 43' W. 285.99'

N. 0° 06' 15" E  
 329.88'

N. 0° 06' 15" E  
 324.99'

N. 0° 06' 15" E  
 319.89'

TRACY ST.  
 S. 88° 42' 15" W. 287.09'

1/2 in. iron pipe