

LEGEND

- Set 5/8" X 30" rebar with plastic cap marked "HANLEY ENGR. PLS 1206."
- ☐ Found city monument in steel case.
- () Plat distance

NARRATIVE

The purpose of this survey for Grant County Credit Union is to mark on the ground the corners of Block 32, Leven's Addition to Baker, Oregon. Monuments governing this survey were recovered on 9th Street and 11th Street on "G" and "H" Streets. Bearings were held from P.H. Anderson Blue Ridge Subdivision Plat of 1946, Anderson maps of survey of 1947 and 1948, filed with City Engineer as Nos. AD 19 16 and AD 19 19, Baker County Surveys No. 9-40-9 and 9-40-212. Highway No. 30 alignment along a 1° curve was reconstructed by ties to property corner monuments along the Easterly right of way line between "G" Street and Hughes Lane, wherein the curve radius point was located.

MAP OF SURVEY


BLOCK 32, B.W. LEVEN'S ADD.

IN BAKER, OREGON

Surveyed Feb. 29, 1996 for
Grant County Credit Union
SCALE: 1" = 100'

HANLEY ENGINEERING
2043 MAIN STREET
BAKER CITY, OREGON

FILED 4-08-96
BAKER COUNTY SURVEYOR
SURVEY NO. 9-40-433

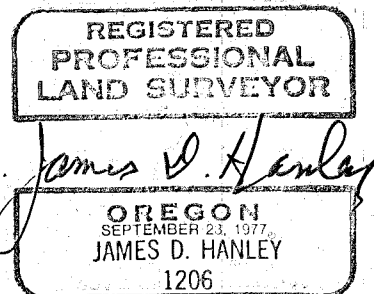

Renews June 30, 1997