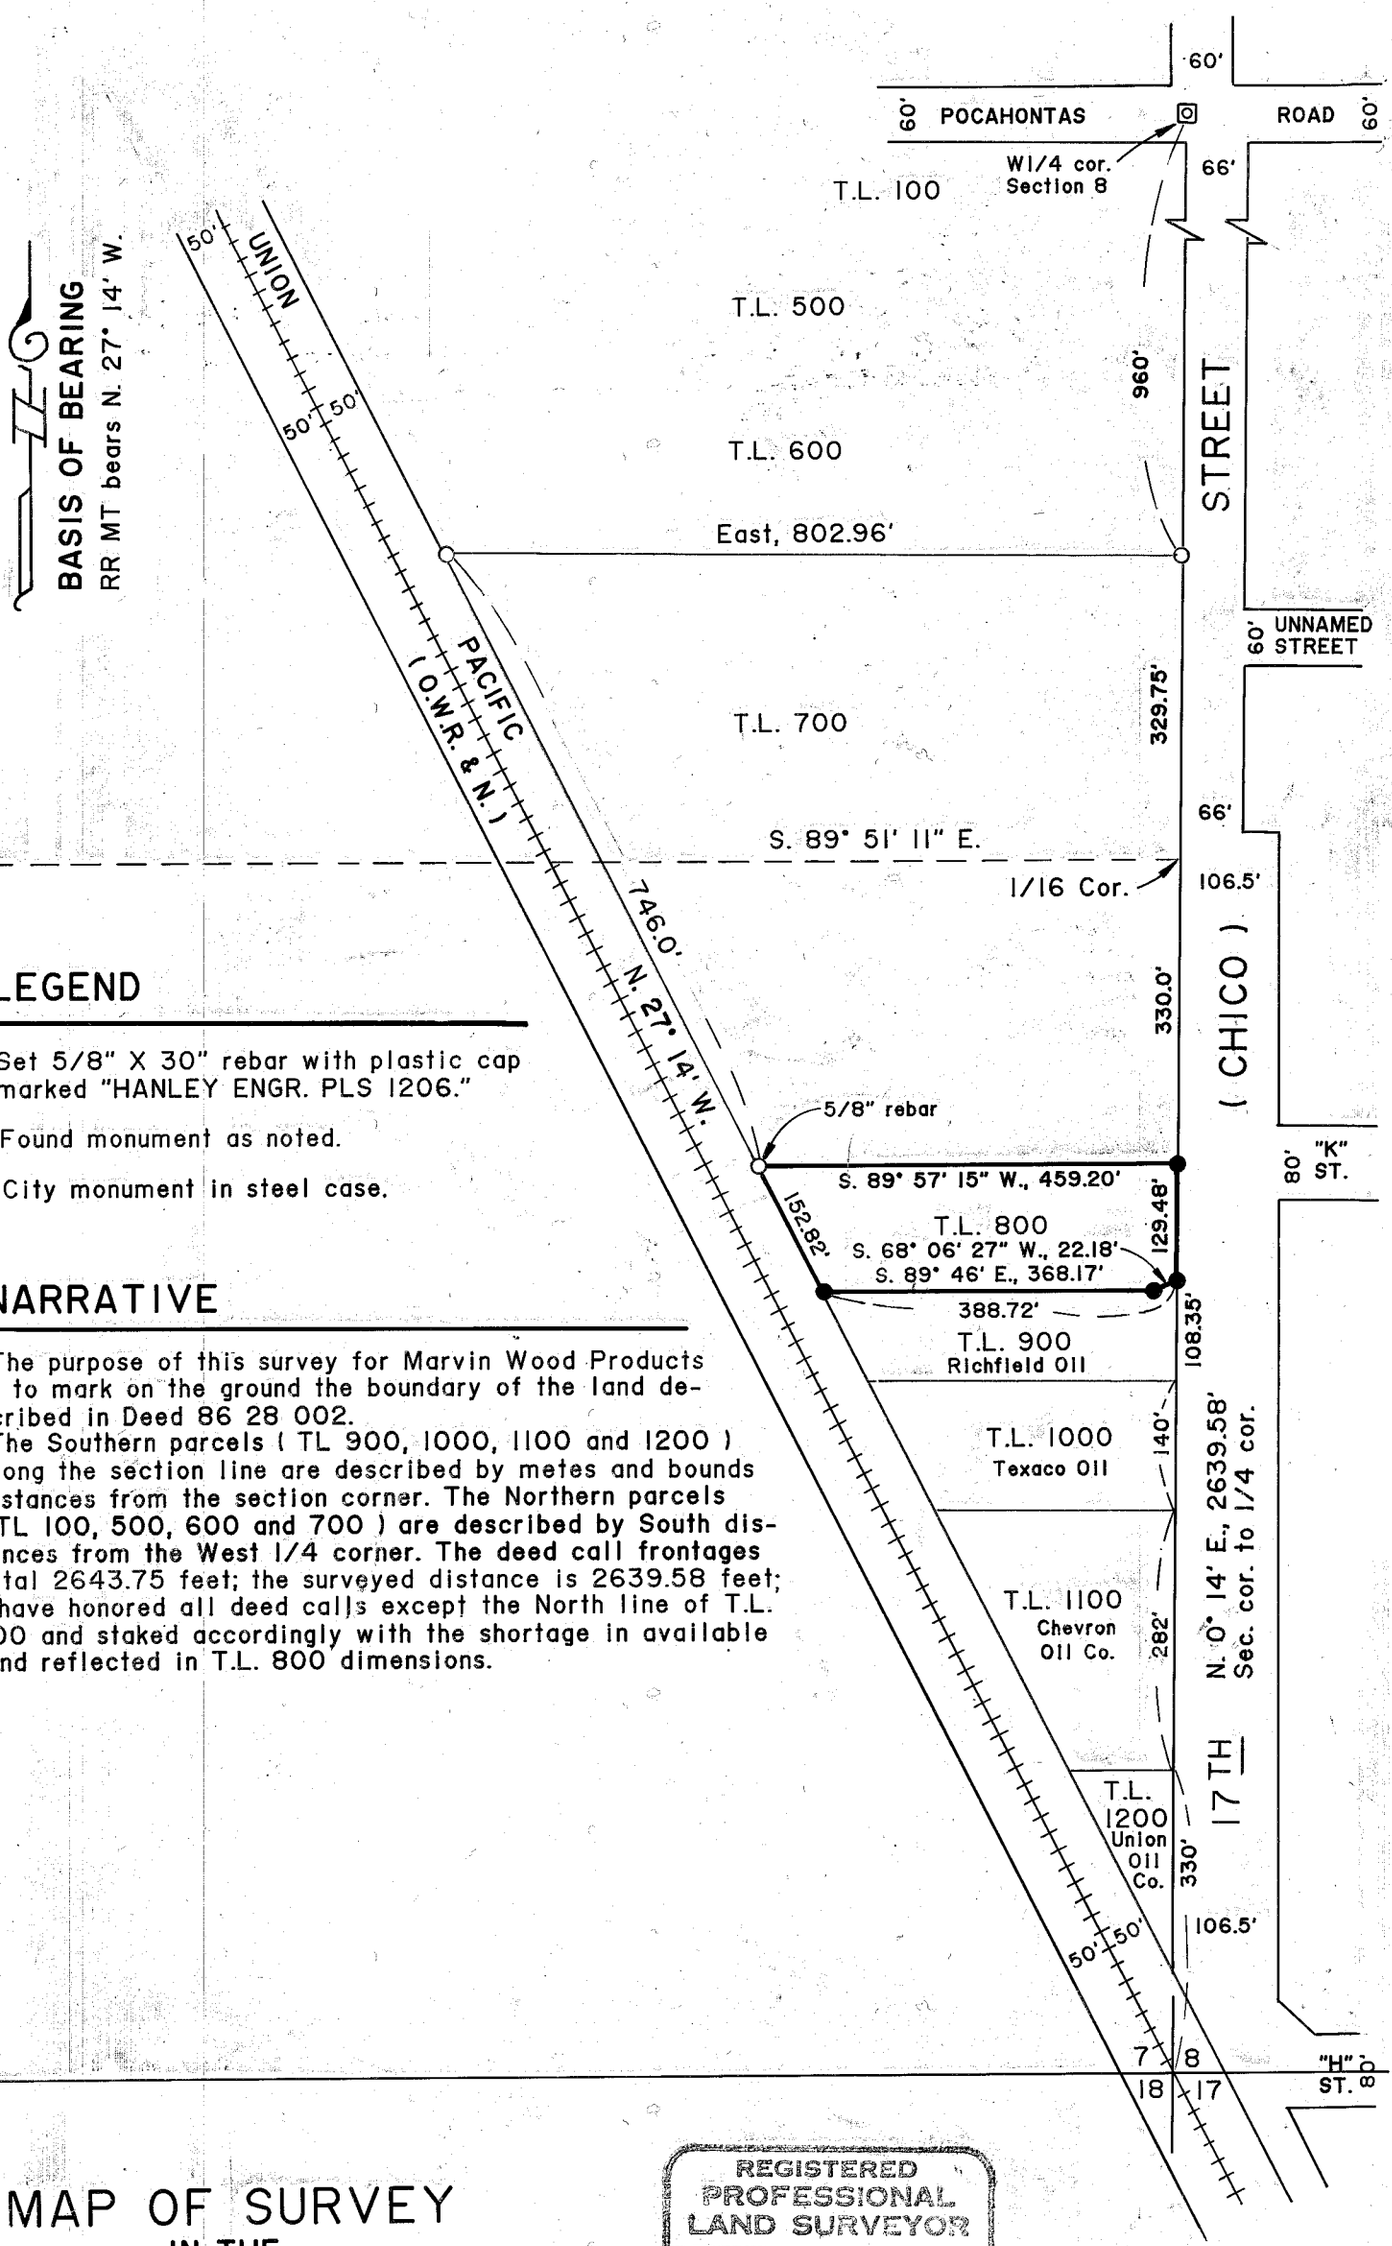

BASIS OF BEARING
RR MT bears N. 27° 14' W.

LEGEND

Set 5/8" X 30" rebar with plastic cap marked "HANLEY ENGR. PLS 1206."

Found monument as noted.

City monument in steel case.

NARRATIVE

The purpose of this survey for Marvin Wood Products to mark on the ground the boundary of the land described in Deed 86 28 002.

The Southern parcels (TL 900, 1000, 1100 and 1200) long the section line are described by metes and bounds stances from the section corner. The Northern parcels TL 100, 500, 600 and 700) are described by South distances from the West 1/4 corner. The deed call frontages tal 2643.75 feet; the surveyed distance is 2639.58 feet; have honored all deed calls except the North line of T.L. 00 and staked accordingly with the shortage in available nd reflected in T.L. 800 dimensions.

MAP OF SURVEY

IN THE

/4 Sec. 7, T. 9 S., R. 40 E., W.M.

Surveyed Aug. 29 and Nov. 8, 1996

For Marvin Wood Products

Scale: 1" = 200'

REGISTERED PROFESSIONAL LAND SURVEYOR

James D. Hanley

OREGON
SEPTEMBER 23, 1977
JAMES D. HANLEY
1206

Renews June 30, 1997

HANLEY ENGINEERING
2043 MAIN STREET
BAKER CITY, OREGON

FILED 11-25-96
BAKER COUNTY SURVEYOR
SURVEY NO. 9-40-448