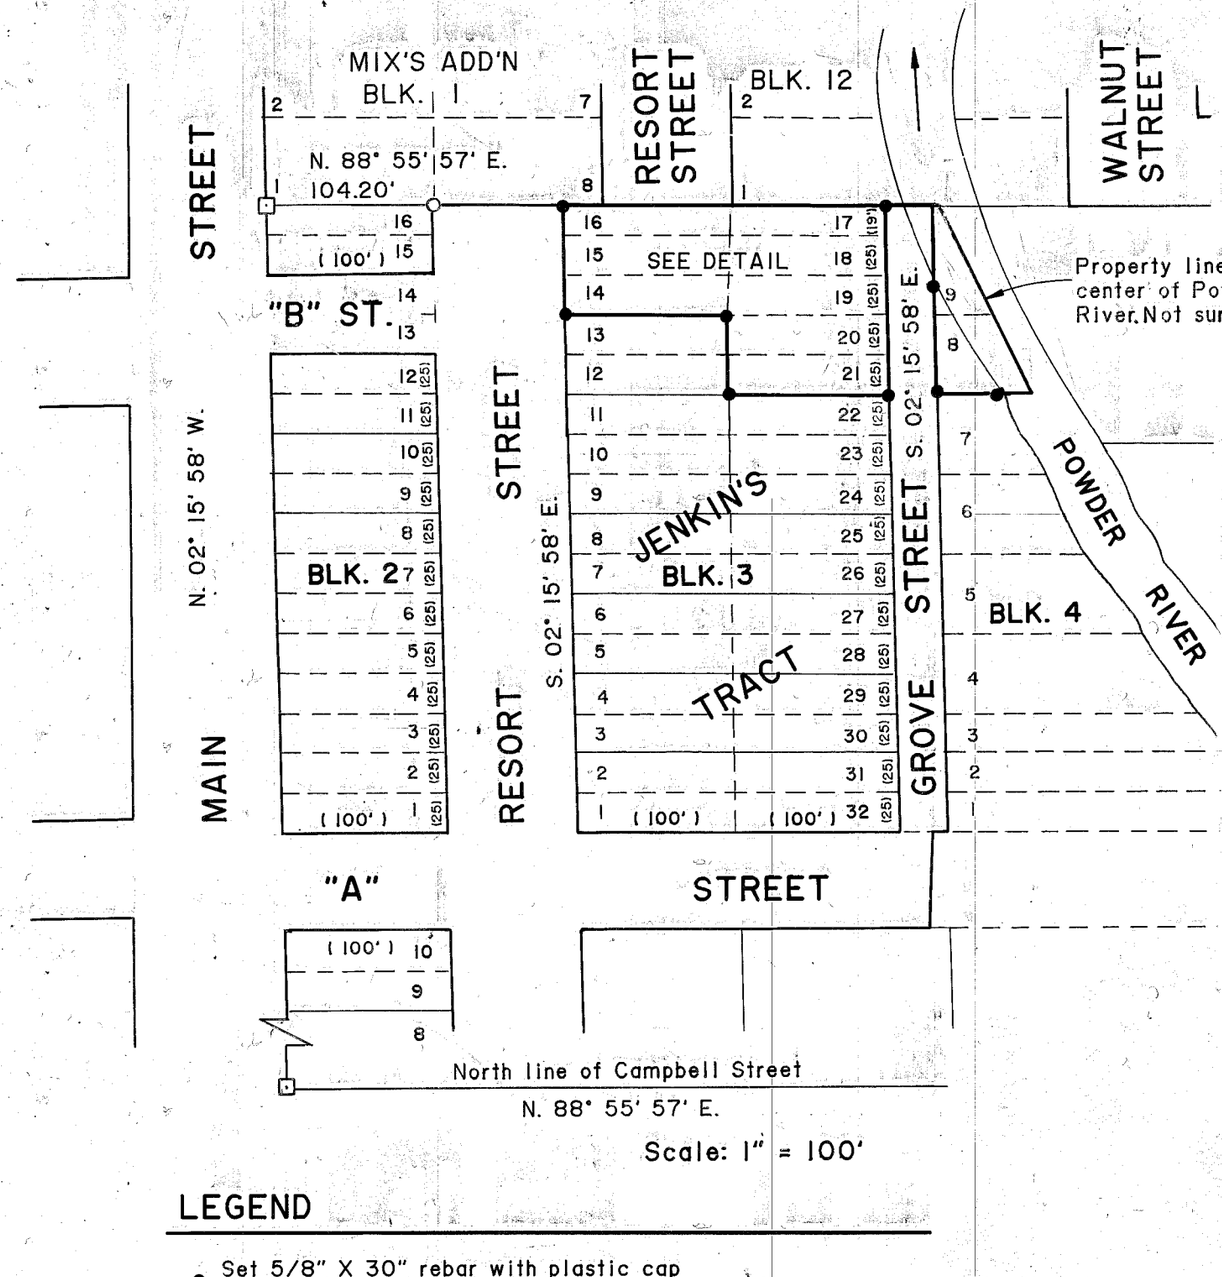

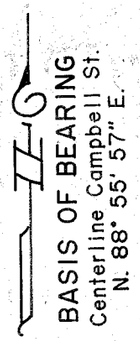

NARRATIVE

The purpose of this survey for Harold C. and Marjorie L. Sundean is to mark on the ground the corners of the parcel described in Deed 94 22 and make survey ties to fence encroachments from which descriptions m be prepared for transfer of encroached areas to the Sundeans.

Recovery was made of the monuments marking Resort Street center line East line Main Street, C Street, Campbell Street center line and those shown on Survey No. 9-40-238.

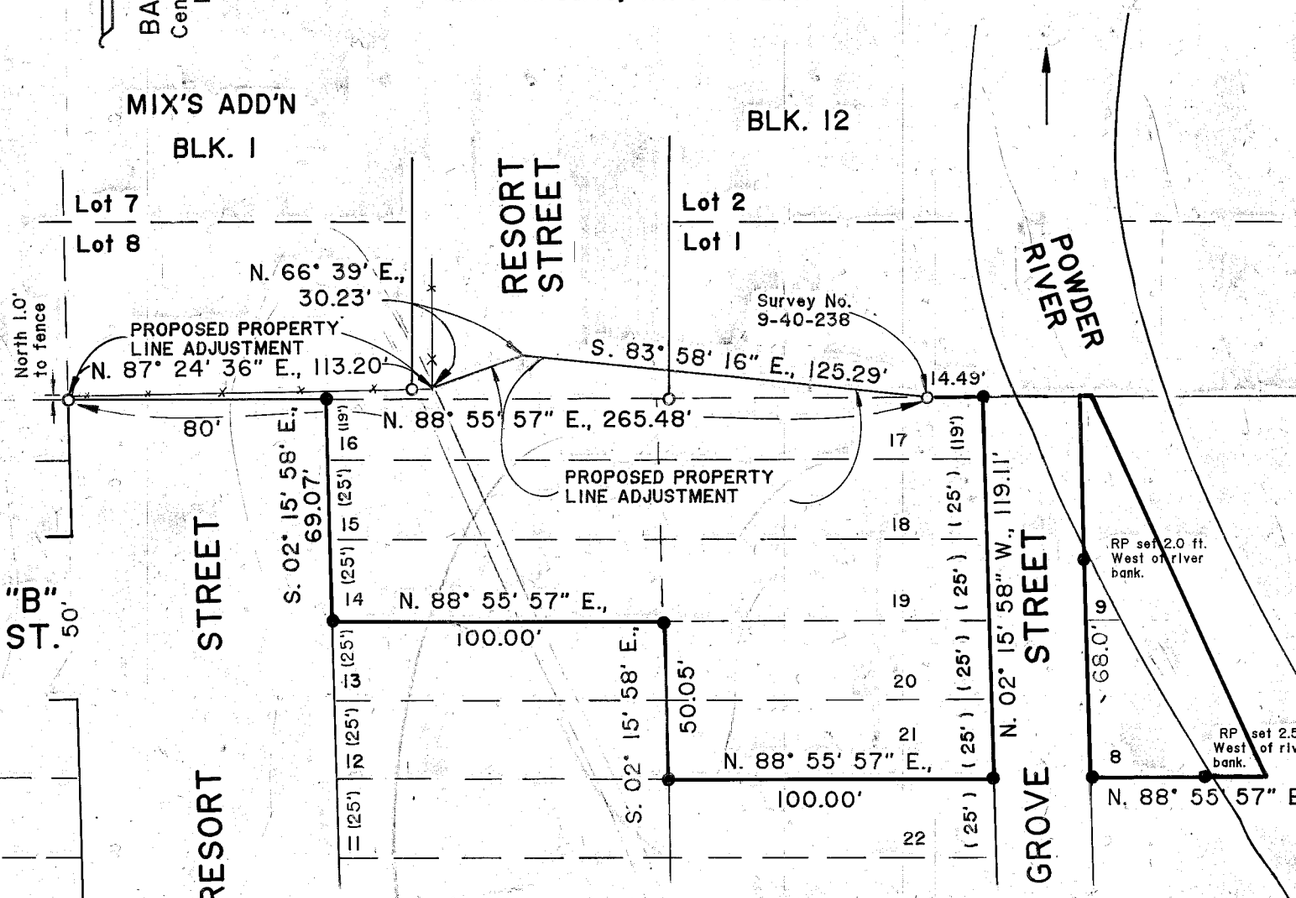

DETAIL
NO SCALE

LEGEND

- ● Set 5/8" X 30" rebar with plastic cap marked "HANLEY ENGR. PLS 1206."
- ○ Found 5/8" rebar PLS 1639
- ⊡ City monument in steel case.
- ( ) Plat distance.

HANLEY ENGINEERING
2043 MAIN STREET
BAKER CITY, OREGON

REGISTERED PROFESSIONAL LAND SURVEYOR
James D. Hanley
OREGON
SEPTEMBER 23, 1977
JAMES D. HANLEY
1206

Renews June 30, 1997

FILED DEC. 02, 1996
BAKER COUNTY SURVEYOR
SURVEY NO. 9-40-450

MAP OF SURVEY

OF LOTS 14 - 21, BLOCK 3 AND LOTS 8 & 9, BLOCK 4 JENKIN'S TRACT TO BAKER CITY, OREGON

For Harold Sundean

Surveyed Sept. 5, and Oct. 25, 1996

Scale: As shown