


FOUND, O.S.H.D. R/W MON.
250' RT. OF STA. 2177+00

SET 1/2" REBAR
THIS SURVEY.

CAMPBELL STREET
INTERCHANGE
INTERSTATE-80 N

FOUND, O.S.H.D. R/W MON.
340' RT. OF STA. 2181+00

SE 1/4 NE 1/4 SEC. 16
T. 9S., R. 40E., W.M.

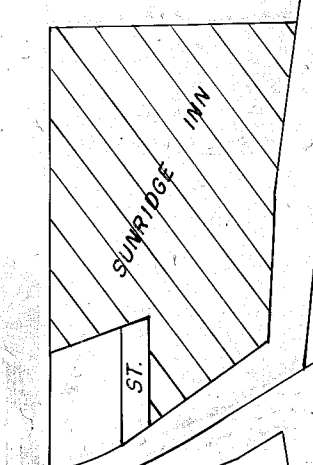

VICINITY MAP
1" = 400'

UNDERGROUND POWER	---
GAS	---
WATER	---
SEWER	---

MAP OF SURVEY

SUNRIDGE INN TRACT,
BUILDINGS AND UTILITIES

Surveyed April 15, 1974
Scale 1" = 50'

FILED MAY 23, 1997
BAKER COUNTY SURVEYOR
SURVEY NO. 9-40-464

