

CERTIFIED RECORD OF LAND CORNER MONUMENTATION


History of original corner establishment:

Corner was not established by GLO.

Corner position was originally established by James D. Hanley RPE 2808, under Baker County Survey 9-40-25BC, dated Jan. 17, 1971, when original subdivision of the NE 1/4 of Section 16 was conducted. Corner was monumented under Baker County Survey 9-40-41BC, dated Feb. 27, 1973. On that map of survey it states:

"Set 1/2" rebar N1/16 S16 | S15 "

K-13

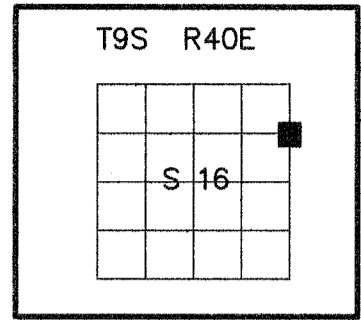

Description of corner evidence found:

Found a 1/2 in. dia. iron rod with yellow plastic cap marked RPE 2808 in old wire fence with steel fence post set alongside.

Description of monument and accessories I established to perpetuate original location of this corner:

Set a 2 3/8 in. diam. brass cap, on a 1 1/4 in. diam. by 30 in. long, iron pipe, buried 27 ins. in the ground, with rock collar and steel fence post set alongside, 1.2 ft. westerly.

Marked as shown:



From which:

A 5/8 in. diam. by 30 in. long iron rod with 1 1/2 in. dia. aluminum cap marked: LS 51277 2000, bears N 45° E, 10.08 ft. dist., with steel fence post set 1ft. easterly.

A 5/8 in. diam. by 30 in. long iron rod with 1 1/2 in. dia. aluminum cap marked: LS 51277 2000, bears N 45° W, 9.96 ft. dist., with steel fence post set 1ft. westerly.

NOTE: No other suitable bearing objects available.

I hereby certify that the corner was monumented and accessories taken as described, using a Nikon total station, and steel tape, on August 1, 2000.

Witness: Peter C. Elder

REGISTERED PROFESSIONAL LAND SURVEYOR

*Peter C. Elder*

OREGON JULY 13, 1999 PETER C. ELDER 51277

Renewal Date: December 31, 2000

FILED AUG. 30, 2000 BAKER COUNTY SURVEYOR SURVEY NO. 9-40-521

Office of ..... County Surveyor ..... County of ..... Baker ..... State of ..... Oregon ..... , I hereby certify that the within instrument was filed in this office for record on the ..... day of ..... , 19 ..... by ..... (COUNTY SURVEYOR) ..... (DEPUTY)