


RECORD OF SURVEY
 S.W. ¼ SEC. 17, T.9S., R.40E., W.M.
 BAKER COUNTY, OREGON

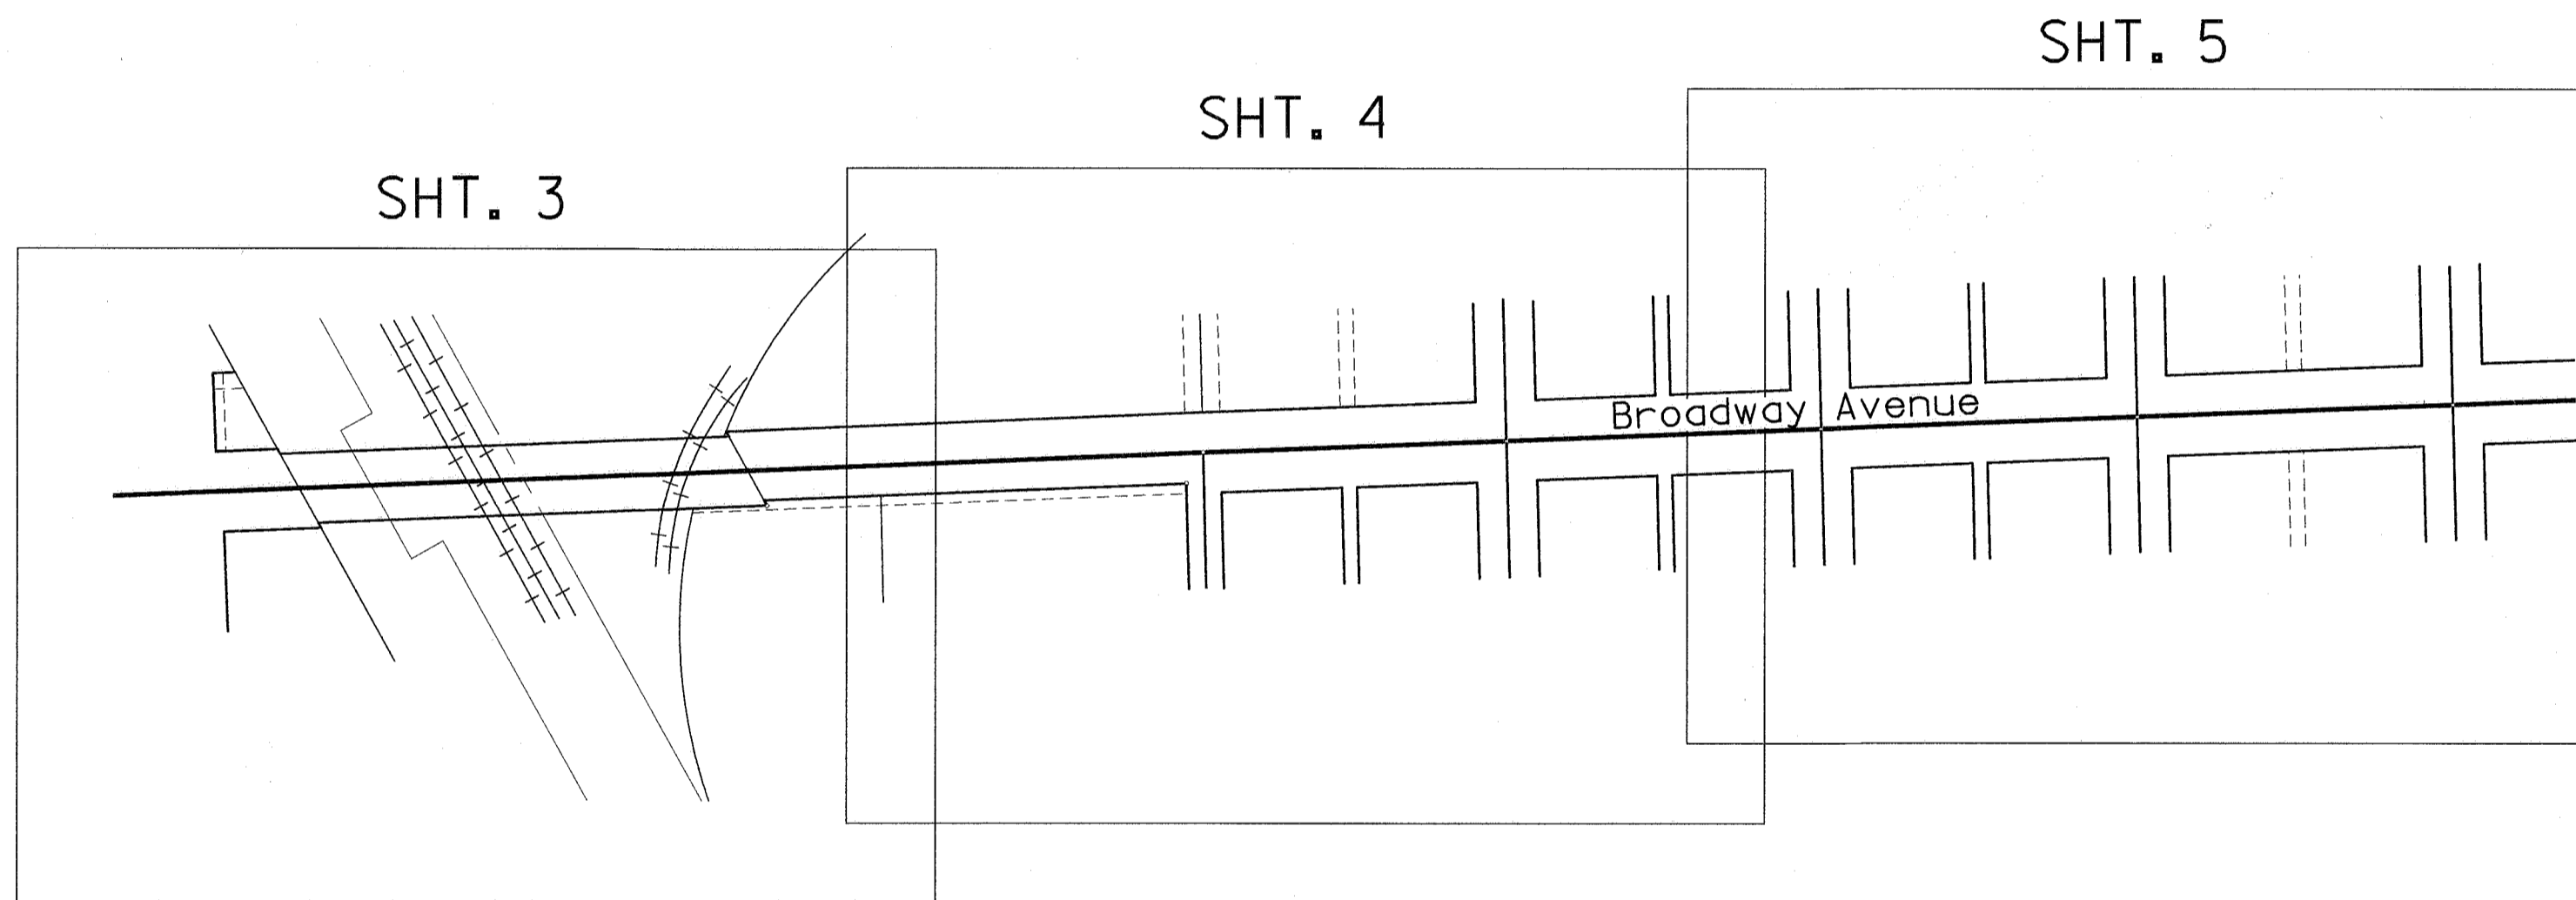

SHEET INDEX
 NO SCALE

03/16/2001

I:\Projects\019\01906602\Survey\MS\10554\filed_survey.dgn

REGISTERED
 PROFESSIONAL
 LAND SURVEYOR

OREGON
 JULY 13, 1999
 MICHAEL S. SWANSON
 #56296

RENEWAL DATE: JUNE 30, 2002
 SIGNED: 3-16-2001



CONSULTING
 ENGINEERS

920 COUNTRY CLUB RD., SUITE 100B
 EUGENE, OREGON 97401
 TEL. (541) 683-6090 FAX. (541) 683-6576

CENTER LINE RESOLUTION,
 MONUMENT RECOVERY AND CONTROL SURVEY
BROADWAY AVENUE BICYCLE PATH

FOR BAKER CITY, BAKER COUNTY AND
 OREGON DEPARTMENT OF TRANSPORTATION
 MARCH 2001

NO SCALE

<u>M.L. DOMESTICO, CHIEF SURVEYOR</u>	OBEC	DESIGNED: M. SWANSON	PROJ. NO. 19-66.2	SHT: 2 OF 5
APPROVED BY:	TITLE	DRAWN: AD	CHK'D: MLA	FILE NO. 10854S

FILED MARCH 26, 2001
 BAKER COUNTY SURVEYOR
 SURVEY NO. 9-40-529