

RECORD OF SURVEY
 S.W. ¼ SEC. 17, T.9S., R.40E., W.M.
 BAKER COUNTY, OREGON

STEWART'S

SECOND

ADDITION

MATCH SHEET 3

MATCH SHEET 4

Ellingson Lumber Co.
 74-47-020

F.S. & C. McLean
 98-04-017

Secretary of H.U.D.
 B0040-0101

E.L. & S.L. Tilton
 97-48-128

Broadway Avenue

N 87°40'44" E
 N 89°18'21" E 9-40-506
 N 89°17'55" E 9-40-281

N 87°46'51" E
 N 89°09' E 9-40-479

N 87°47'08" E

Ellingson Lumber Co.
 Bk. 173 Pg. 465

Ellingson Lumber Co.
 68-17-019

D.J. Hulick
 81-48-093

W.G. & B.R. Bigley
 72-15-080

M.D. Conn
 99-40-253

13th Street

14th Street

STEWART'S

SECOND

ADDITION

REGISTERED
 PROFESSIONAL
 LAND SURVEYOR

OREGON
 JULY 13, 1999
 MICHAEL S. SWANSON
 #56296


RENEWAL DATE: JUNE 30, 2002
 SIGNED: 3-16-2001

LEGEND

- MONUMENT FOUND AS NOTED IN TABLE.
- △ PROJECT CONTROL POINT FOUND OR SET AS NOTED IN TABLE.
- CALCULATED POSITION
- N 70°46'22"E MEASURED INFORMATION
- N 69°01'30" E RECORD INFORMATION

N

SCALE 1:500

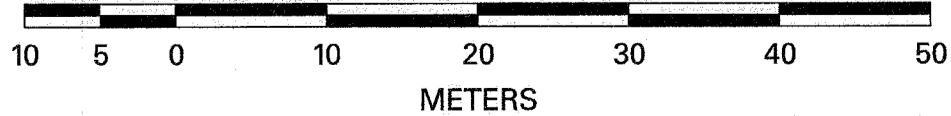

CONSULTING ENGINEERS

920 COUNTRY CLUB RD., SUITE 100B
 EUGENE, OREGON 97401
 TEL. (541) 683-6090 FAX. (541) 683-6576

CENTER LINE RESOLUTION,
 MONUMENT RECOVERY AND CONTROL SURVEY
 BROADWAY AVENUE BICYCLE PATH

FOR BAKER CITY, BAKER COUNTY AND
 OREGON DEPARTMENT OF TRANSPORTATION

MARCH 2001

SCALE: 1:500

APPROVED BY: *M.L. Swanson* OBEC TITLE

DESIGNED: M. SWANSON	PROJ. NO. 19-66.2	SHT. 4 OF 5
DRAWN: AD	CHK'D: MLA	FILE NO. 10856S

FILED MARCH 26, 2001
 BAKER COUNTY SURVEYOR
 SURVEY NO. 9-40-529