


CERTIFIED RECORD OF LAND CORNER MONUMENTATION

DIAGRAM

History of original corner establishment:

The original corner was set by Thompson & Chaplin, Deputy Surveyors, under Contract No. 104, dated April 16, 1864.

The original notes state:
Set post for 1/4 Sec corner in mound of Earth with charred stake, pit, & trench as per instructions.

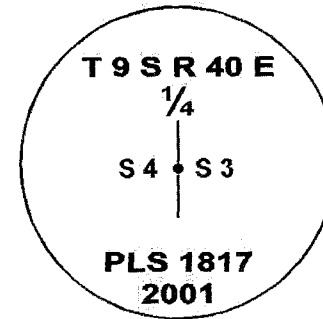

Description of corner evidence found:

An extensive search was made for the original post. No original corner evidence found. Found 12" spike set by Baker County Partition Plat No. P2001-018. Spike is set approximately 6" West of a fence intersection. Fences run North, South, and East from fence intersection.

Description of monument and accessories I established to perpetuate the original location of the corner:

The corner was reestablished at the position of the said 12" spike. Set a 2 1/2" diameter brass cap on a 1" x 30" galvanized pipe, 4" above ground. The cap is marked as shown in the corner diagram.

Corner monument references:
From the corner monument:

A 5/8" x 30" rebar with yellow plastic cap marked "HANLEY ENGR. PLS 1817" bears S. 87° 06' 29" E., 36.92'. Set in an East-West running fence line, approximately 6" below ground.

A 5/8" x 30" rebar with yellow plastic cap marked "HANLEY ENGR. PLS 1817" bears S. 0° 08' 10" W., 26.70'. Set in a North-South running fence line, approximately 6" below ground.

A 5/8" x 30" rebar with yellow plastic cap marked "HANLEY ENGR. PLS 1817" bears N. 1° 17' 59" E., 23.16'. Set in a North-South running fence line, approximately 6" below ground.

Reference survey and basis of bearing: Baker County Partition Plat No. P2001-018.

I, Thomas J. Hanley certify that this corner was properly reestablished as witnessed by Eric Stricker and Kirby Danford on November 12, 2001.

FILED _____ November 13, 2001
BAKER COUNTY SURVEYOR
SURVEY NO. _____ 9-40-541
CORNER PRES. NO. _____ CP #62

**REGISTERED
PROFESSIONAL
LAND SURVEYOR**

Thomas J. Hanley

OREGON
JULY 13, 1979
THOMAS J. HANLEY
1817

Renews June 30, 2003