


CERTIFIED RECORD OF LAND CORNER MONUMENTATION

DIAGRAM

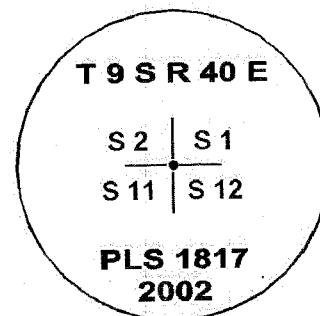

History of original corner establishment:

The original corner was set by Thompson and Chaplin, under Contract No. 104, dated April 16, 1864.

The original notes state:
Set post for cor to secs 1, 2, 11 and 12 in mound of earth with pits and trenches as per instructions.

Baker County Survey No. 9-40-51 states:
Original corner post has been destroyed by farming operations.
Corner position remonumented as follows:

Found the original stone marking the quarter section corner between Sections 1 and 12 and re-established the section corner by intersecting county road (built on East line of Section 2) with line connecting the southwest corner of Section 2 with the aforesaid quarter section corner.

Set a 2½ inch brass cap on a 1 inch iron pipe 31 inches long and projecting 5 inches out of ground.

Description of corner evidence found:

No evidence found. Monument set by Baker County Survey No. 9-40-51 has been destroyed by farming operations again.

Description of monument and accessories I established to perpetuate the original location of the corner:

Ties were made to monumentation from Baker County Survey No. 9-40-49 to establish the same basis of bearing as said survey. Corner was reestablished at position as shown on Baker County Survey No. 9-40-49.

Set a 2½" diameter brass cap on a 1" x 30" galvanized pipe. The cap is marked as shown in the corner diagram.

Corner monument references:

From the corner monument:

A 5/8" x 30" rebar with orange plastic cap marked "REFERENCE MONUMENT" bears N. 16° 52' 18" E., 11.58', set approximately 1' below ground in a North-South running fence line.

A 5/8" x 30" rebar with orange plastic cap marked "REFERENCE MONUMENT" bears S. 24° 32' 41" E., 10.11', set approximately 1' below ground in a North-South running fence line.

Reference survey and basis of bearing:

Baker County Survey No. 9-40-558.

I, Thomas J. Hanley certify that this corner was properly reestablished as witnessed by Kirby Danford and Asa Langrell on July 15, 2002.

FILED September 23, 2002
BAKER COUNTY SURVEYOR
SURVEY NO. 9-40-559
CORNER PRES. NO. CP #91

REGISTERED
PROFESSIONAL
LAND SURVEYOR

Thomas J. Hanley

OREGON
JULY 13, 1979
THOMAS J. HANLEY
1817

Renews June 30, 2003