

CERTIFIED RECORD OF LAND CORNER MONUMENTATION

DIAGRAM

History of original corner establishment:

The original corner was set by Timothy W. Davenport, Deputy Surveyor, under Contract No. 102, dated July 20, 1863.

The original notes state:
Set qtr sec post, made mound of Earth and drove charred stakes as per instructions.

Baker County Survey No. 9-40-49 reestablished this position through ties to Oregon State Highway Department monumentation. No monument was set at that time.

Description of corner evidence found:

No evidence found.

Description of monument and accessories I established to perpetuate the original location of the corner:

Ties were made to monumentation from Baker County Survey Numbers 9-40-25 and 9-40-49 to establish the same basis of bearing as said surveys. Corner position was reestablished N. 11° 35' E., 2364.8' from O.S.H.D. P.I. 242+87.5 as per Baker County Survey No. 9-40-49.

Set a 2½" diameter brass cap on a 1" x 30" galvanized pipe. The cap is marked as shown in the corner diagram.

Corner monument references:

From the corner monument:

A 5/8" x 30" rebar with orange plastic cap marked "REFERENCE MONUMENT" bears N. 47° 33' 31" E., 11.46', set approximately 8" below ground.

A 5/8" x 30" rebar with orange plastic cap marked "REFERENCE MONUMENT" bears S. 49° 47' 02" E., 11.79', set approximately 8" below ground.


A 5/8" x 30" rebar with orange plastic cap marked "REFERENCE MONUMENT" bears S. 37° 44' 26" W., 9.34', set approximately 8" below ground.

A 5/8" x 30" rebar with orange plastic cap marked "REFERENCE MONUMENT" bears N. 43° 33' 02" W., 9.99', set approximately 8" below ground.

Reference survey and basis of bearing: Baker County Survey No. 9-40-558.

I, Thomas J. Hanley certify that this corner was properly reestablished as witnessed by Kirby Danford and Asa Langrell on July 11, 2002.

FILED September 23, 2002
BAKER COUNTY SURVEYOR
SURVEY NO. 9-40-560 / 8-40-16
CORNER PRES. NO. CP #92

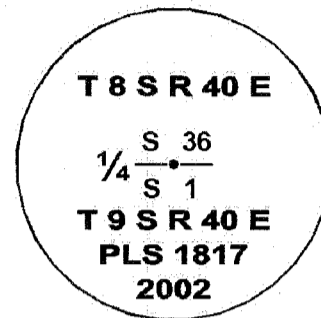

**REGISTERED
PROFESSIONAL
LAND SURVEYOR**

Thomas J. Hanley

OREGON
JULY 13, 1979
THOMAS J. HANLEY
1817

Renews June 30, 2003