

CERTIFIED RECORD OF LAND CORNER MONUMENTATION

DIAGRAM

History of original corner establishment:

The original corner was set by Thompson & Chaplin, Deputy Surveyors, under Contract No. 104, dated April 16, 1864.

The original notes state:

“Set stone 20 x 12 x 4 in for ¼ Sec corner.”

Baker County Survey No. 9-40-33B states:


“Found a marked stone with ¼ very faint on the north face, stone in mound as per GLO notes”

Baker County Survey No. 9-40-37 states:

“Found GLO stone. 20 x 12 x 4 in mound stone.”

Baker County Survey No. 9-40-535 states:

“Found 12" x 10" x 4" stone located in small mound of stone in an East-West running fence line. Set 12" spike under stone.”

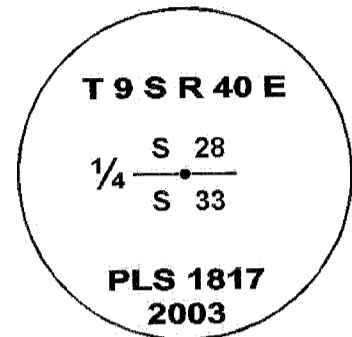

Description of corner evidence found:

Found stone 12" x 10" x 4" in small mound of stone in an East-West running fence line. No markings were visible. Found 12" spike under stone.

Description of monument and accessories I established to perpetuate the original location of the corner:

Set a 2½" diameter brass cap on a 1" x 30" galvanized pipe at the position occupied by the 12" spike. Top of monument is approximately 6" above ground surface. The cap is marked as shown in the corner diagram. Buried the stone on the North side of the monument. Left approximately 4" of the stone exposed. Built mound of stone around monument.

Corner monument references:

A 5/8" x 30" rebar with orange plastic cap marked "REFERENCE MONUMENT" bears N. 45° E., 10.17', set flush with the ground.

A 5/8" x 30" rebar with orange plastic cap marked "REFERENCE MONUMENT" bears S. 45° E., 10.29', set flush with the ground.

A 5/8" x 30" rebar with orange plastic cap marked "REFERENCE MONUMENT" bears S. 45° W., 10.24', set flush with the ground.

A 5/8" x 30" rebar with orange plastic cap marked "REFERENCE MONUMENT" bears N. 45° W., 9.92', set flush with the ground.

Reference monuments set with a staff compass and steel chain.

I, Thomas J. Hanley certify that this corner was properly reestablished as witnessed by Kirby Danford and Asa Langrell on July 21, 2003.

FILED December 5, 2003
BAKER COUNTY SURVEYOR
SURVEY NO. 9-40-582
CORNER PRES. NO. CP #105

REGISTERED
PROFESSIONAL
LAND SURVEYOR

Thomas J. Hanley

OREGON
JULY 13, 1979
THOMAS J. HANLEY
1817

Renews June 30, 2005