


CERTIFIED RECORD OF LAND CORNER MONUMENTATION

History of original corner establishment:

Corner was originally established in Survey 9-40-535, filed on June 15, 2001. No separate monument record was filed.

Map of Survey states:

Set 5/8" rebar with plastic cap marked "HANLEY ENGR. PLS 1817"

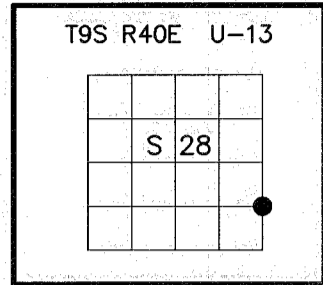

Description of corner evidence found:

Corner was apparently removed subsequent to survey by unknown party, (see Baker County Circuit Court Case No. 02-484).


At the time of reestablishment of this corner by survey, I did find the bottom 4 in. of a wooden survey lathe near corner position.

Description of monument and accessories I established to perpetuate original location of this corner:

At the position by survey as shown on Survey No. 9-40-588 :

Set a 3 1/4 in. dia. alum. cap on a 2 3/8 in. dia. by 30 in. long alum. post, buried 24 ins. in the ground.
Placed a rock collar around monument.

Marked as shown:

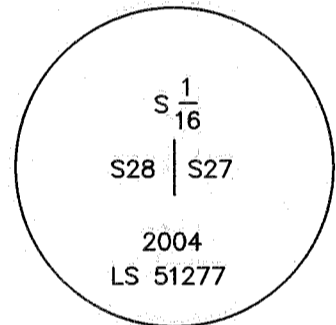

From which:

A 1 1/2 in. dia. alum. cap marking O.S.H.D. ROW, bears N 21°03'39" E, 168.81 ft. dist. in a fence "T" N-S-W.

Cap is not marked, nearby paddle marked:
EQ P.O.T. L 2266+18.78 BK 600' RT, and also marked
P.S. WB 106+93.37 AH 20 LT, P.O.T. EB 106+93.37 20 RT.

A 1 1/2 in. dia. alum. cap marking O.S.H.D. Backsight point bears S 80°26'09" E, 380.49 ft. dist. 4 ft. E'ly of N-S fence.

Cap is not marked, nearby paddle marked:
P.O.T. B 109+50.00 Backsight.

I hereby certify that the corner was monumented as described on February 3, 2004 and accessories taken with a total station, using Grid bearing, North Zone of Oregon Coordinate System as shown on Survey 9-40-588.

Witness: Peter C. Elder

REGISTERED
PROFESSIONAL
LAND SURVEYOR

Peter C. Elder

OREGON
JULY 13, 1999
PETER C. ELDER
51277

Renewal Date: Dec. 31, 2005

FILED MARCH 5, 2004
BAKER COUNTY SURVEYOR
SURVEY NO. 9-40-589
CP # 107