
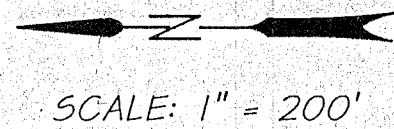


PROJECT PRIMARY SURVEY CONTROL TABLE

POINT	NORTHING	EASTING	DESCRIPTION	RECORD REFERENCE
1	415726.7000	8897015.5400	1/2" REBAR IN CASE	VOL. 13, PG. 88
44	416341.9850	8897043.7490	1" IRON ROD IN CASE	VOL. 13, PG. 88
49	418065.0820	8896963.6520	5/8" IRON ROD IN CASE	VOL. 13, PG. 88
50	416720.6000	8896993.5240	1" IRON ROD IN CASE	VOL. 13, PG. 88
69	417566.5710	8897017.2620	5/8" REBAR W/ YPC "JUB"	NO RECORD FOUND IN BAKER CO. SURVEY RECORDS

MONUMENT TABLE

POINT	NORTHING	EASTING	DESCRIPTION	RECORD REFERENCE
1	415726.7000	8897015.5400	1/2" REBAR IN CASE	VOL. 13, PG. 88
4	416141.8000	8897048.8900	5/8" REBAR WITH YPC	9-40-677
5	416073.8300	8897050.4000	5/8" REBAR WITH YPC	9-40-677
44	416341.9850	8897043.7490	1" IRON ROD IN CASE	VOL. 13, PG. 88
49	418065.0820	8896963.6520	5/8" IRON ROD IN CASE	VOL. 13, PG. 88
50	416720.6000	8896993.5240	1" IRON ROD IN CASE	VOL. 13, PG. 88
69	417566.5710	8897017.2620	5/8" REBAR W/YPC "JUB"	NO RECORD FOUND IN BAKER CO. SURVEY RECORDS
203	416209.3448	8897047.0983	MON 3/4" REBAR NO CAP	PHILO ANDERSON 10/12/56
205	415756.0259	8897056.4609	MON 3/4" IRON PIPE	NO RECORD FOUND IN BAKER CO. SURVEY RECORDS
206	417286.6028	8896936.5234	MON 5/8" IRON PIPE	VOL. 147, PG 262
208	416768.0819	8896992.4820	MON PK	9-40-202
211	417894.6756	8896924.9820	1" OPEN IRON PIPE	NO RECORD FOUND IN BAKER CO. SURVEY RECORDS
1045	417283.5950	8897023.8410	5/8" REBAR. BENT	NO RECORD FOUND IN BAKER CO. SURVEY RECORDS
1046	417275.8750	8897023.9320	5/8" REBAR W/ YPC "JUB"	NO RECORD FOUND IN BAKER CO. SURVEY RECORDS
1047	417267.4180	8897023.9580	5/8" REBAR. NO CAP	NO RECORD FOUND IN BAKER CO. SURVEY RECORDS
1053	416952.2630	8897030.9990	5/8" REBAR. NO CAP	NO RECORD FOUND IN BAKER CO. SURVEY RECORDS
1054	416739.0650	8897035.6860	5/8" REBAR WITH YPC	9-40-677 & OTHERS
1126	415611.2440	8897060.6580	5/8" REBAR WITH YPC	9-40-596
1127	415580.2480	8897061.3090	5/8" REBAR WITH YPC	9-40-596
1128	415565.2000	8897061.6070	5/8" REBAR WITH YPC	9-40-596
1129	416639.8480	8897037.8460	5/8" REBAR WITH YPC	NO RECORD FOUND IN BAKER CO. SURVEY RECORDS

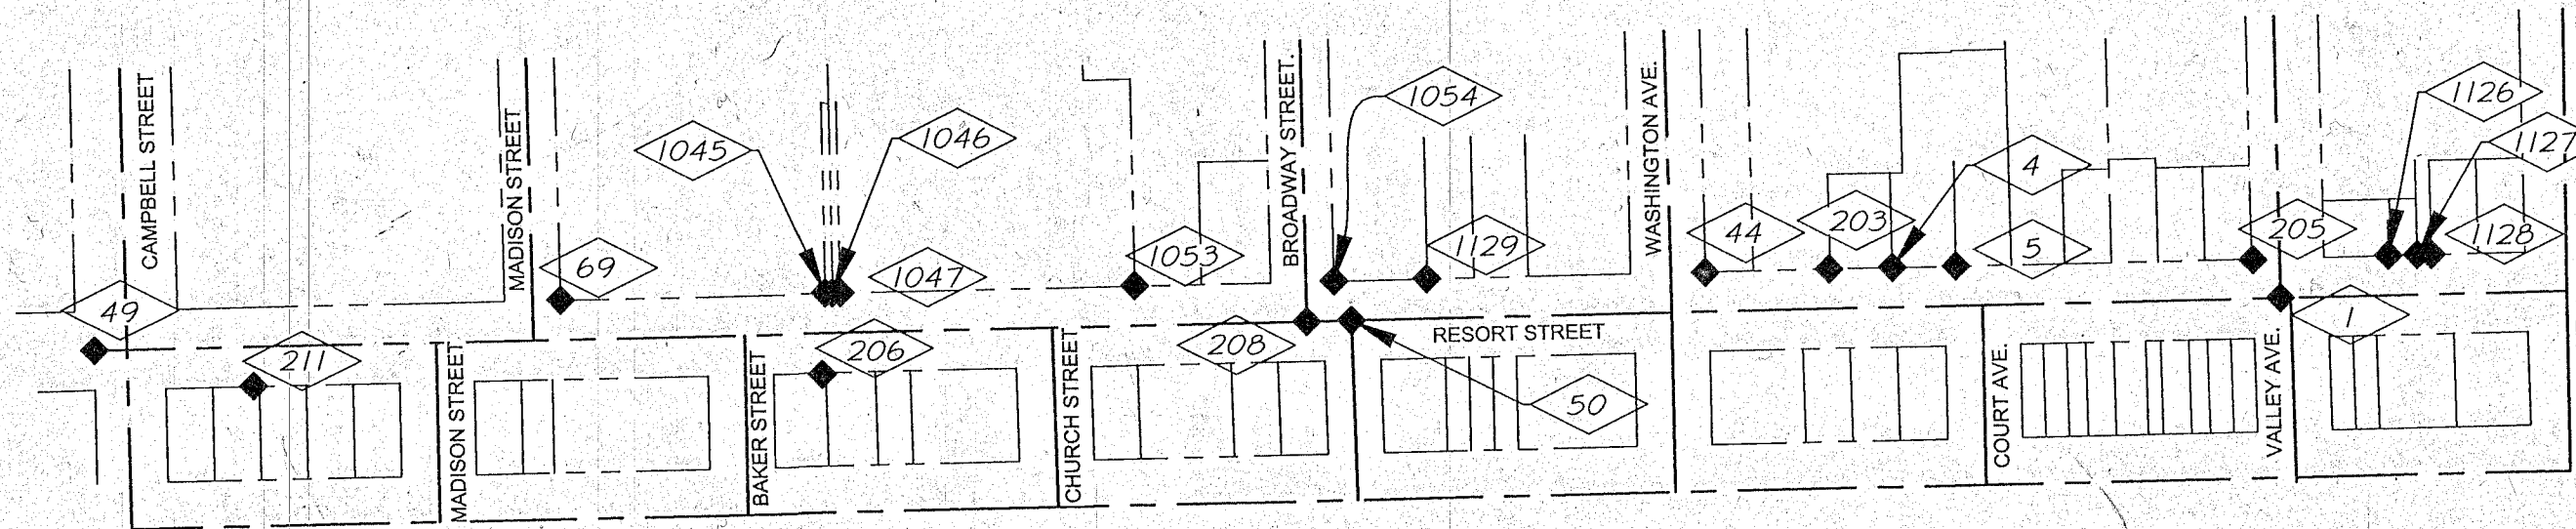

SURVEY NARRATIVE

THIS SURVEY WAS PREPARED AT THE REQUEST OF BAKER CITY PUBLIC WORKS IN ACCORDANCE WITH ORS 209.150 WHICH REQUIRES ANY PERSON OR PUBLIC AGENCY REMOVING, DISTURBING OR DESTROYING A MONUMENT OF RECORD, TO PERPETUATE OR REPLACE SAID MONUMENT.

BAKER CITY PLANS TO RECONSTRUCT AND IMPROVE RESORT STREET. THIS SURVEY DOCUMENTS THE LOCATION AND CHARACTER OF 21 MONUMENTS WHICH WERE FOUND IN THE COURSE OF SURVEYING FOR THE DESIGN AND CONSTRUCTION OF THIS PROJECT.

A CONTROL SURVEY WAS CONDUCTED BY BAKER CITY PUBLIC WORKS PERSONNEL, IN ADDITION AN INITIAL MONUMENT RECOVERY SURVEY WAS COMPLETED. THE SURVEY CONTROL NETWORK AND FOUND MONUMENT POSITIONS WERE SUPPLIED TO THIS OFFICE, ADDITIONAL MONUMENT RECOVERY WAS COMPLETED USING A TRIMBLE S6 ROBOTIC TOTAL STATION WITH A STANDARD DEVIATION OF 0"00'03" IN ANGULAR ERROR, AND 0.01 FT+3PPM IN DISTANCE. THE LOCATION OF THE MONUMENTS LISTED IN THIS SURVEY WERE VERIFIED WITH REDUNDANT MEASUREMENTS AS AN INDEPENDENTLY CHECK ON SAID LOCATIONS.

EVERY EFFORT WILL BE MADE BY THE CONSTRUCTION CONTRACTOR TO PREVENT THE DESTRUCTION OF THESE MONUMENTS. THE CENTERLINE MONUMENTS SHOWN HEREON WILL BE REMOVED AND RESET AT THE CONCLUSION OF CONSTRUCTION EFFORTS. ANY ADDITIONAL MONUMENTS DISTURBED OR DESTROYED DURING CONSTRUCTION WILL ALSO BE REPLACED. A RECORD OF SURVEY WILL BE FILED WITH THE BAKER COUNTY SURVEYOR SHOWING THE LOCATION AND CHARACTER OF THE MONUMENTS THAT ARE REPLACED.

BASIS OF BEARINGS

CITY OF BAKER CITY SURVEY DATUM BASED ON EXISTING CITY CONTROL WHICH IS NAD 83/91, OREGON STATE PLANE COORDINATE SYSTEM, NORTH ZONE, WITH AN APPLIED SCALE FACTOR OF 1.000206000 TO DERIVE GROUND DISTANCES. BEARINGS ARE GRID RELATIVE TO THE OREGON STATE PLANE COORDINATE SYSTEM NORTH ZONE.

REFERENCES

- 9-40-23 13C
- 16C-AD-1812
- 9-40-193
- 9-40-136 BC
- 9-40-385
- 9-40-366
- 9-40-651
- 9-40-202
- 9-40-569
- AD-18-16
- AD-18-10



EXPIRES: 12-31-2014
DATED: 05-15-2013

LEGEND

- ◆ INDICATES FOUND MONUMENT AS DESCRIBED IN MONUMENT TABLE
- ◇ 50 INDICATES MONUMENT POINT NUMBER IN TABLE
- - - - - INDICATES ROAD RIGHT-OF-WAY
- — — — — INDICATES ROAD CENTERLINE

MAP OF SURVEY
MONUMENT RECOVERY AND CONTROL SURVEY
RESORT STREET, BAKER CITY,
BAKER COUNTY OREGON
IN THE SW 1/4, SECTION 16, T.9S., R.40E. W.M.,

BAKER CITY PUBLIC WORKS DEPARTMENT		3050 E STREET BAKER CITY, OR. 97814
SCALE: 1" = 200'	<p>Anderson Perry Associates, Inc. ENGINEERING · SURVEYING · MATERIALS TESTING LA GRANDE, OR. WALLA WALLA, WA.</p>	SHEET
DATE: MAY 13, 2013		1/1
JOB NO. 781-42		

FILED May 17 2013
BAKER COUNTY SURVEYOR
SURVEY NO. 9-40-711