

CERTIFIED RECORD OF LAND CORNER MONUMENTATION

HISTORY OF ORIGINAL CORNER ESTABLISHMENT:

Corner was originally established by David Thompson under GLO Contract Number 104, dated 16 April, 1864. The record states set post for cor. to Secs. 9, 10, 15, and 16 in mound of earth with charred stake, pits and trenches.

No record was found describing the recovery of the original corner or the establishment of a 1/2" Rebar with plastic cap in a monument box. The following is a list of surveys which refer to this corner:

- 9-40-25BC, January 17, 1971 – Accepts fence corner post for corner
- 9-40-64BC, June 30, 1975 – Fnd 1/2" rebar
- 9-40-121BC, April 5, 1978 – Fnd city mon. in box
- 9-46-46, April 6, 1981 – Fnd 1/2" rebar in box
- 9-40-234, September 24, 1985 - Fnd city mon. in box
- PP 1994-002, January 12, 1994 – Fnd 1/2" rebar w/cap in monument case
- PP 1999-015, December 30, 1999 – Fnd city mon. in case
- PP 2001-010, June 29, 2001 – Fnd 1/2" rebar w/yellow plastic cap in mon. box

DESCRIPTION OF CORNER EVIDENCE FOUND:

Fnd. a 1/2" diameter iron rod with remainder of yellow plastic cap in monument box at the intersection of "H" Street and Best Frontage Road.

DESCRIPTION OF MONUMENT AND ACCESSORIES ESTABLISHED TO PERPETUATE THE LOCATION OF THIS RECORD MONUMENT:

The purpose of this record is to document the replacement of a record monument which was removed by construction activities.

At the position of the found monument described above, set a 5/8" diameter by 30" long copper clad iron rod with a 2 1/2" brass cap, 0.7 below the road surface in a monument case, marked as shown.

From which:

A 5/8" X 30" iron rod with 1 1/2" dia. aluminum cap marked: "APA SURVEY NW RP 60000LS" bears N62°53'W, 37.0';


A 5/8" X 30" iron rod with yellow plastic cap marked: "HANLEY ENGR. PLS 1206" bears N88°32'E, 30.1';

A 5/8" X 30" iron rod with 1 1/2" dia. aluminum cap marked: "APA SURVEY 60000LS" bears S27°43'E, 69.8';


A 5/8" X 30" iron rod with 1 1/2" dia. aluminum cap marked: "APA SURVEY 60000LS" bears S40°26'W, 74.0';

NOTE: Bearings shown are grid bearings based on the Oregon State Plane Coordinate System, North Zone (NAD83(2011))

INDEX NO. J-13

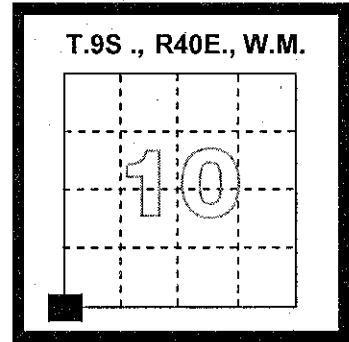

DIAGRAM

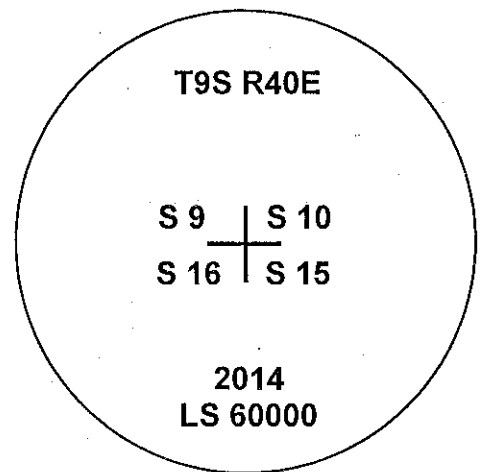

OR NORTH ZONE 3601
N. 420,753.51 iFT
E. 8,900,454.52 iFT
NAD83(2011)

REGISTERED
PROFESSIONAL
LAND SURVEYOR

Jeffrey A. Madsen

OREGON
JUNE 13, 2008
JEFFREY A. MADSEN
60000LS

EXPIRES: 12/31/16

SIGNED: 2/9/15

I hereby certify that the above corner position was perpetuated as hereon described in November, 2014.

Witnesses: Jarrod Hayes LSIT, Ryan Hays, Casey Boyd

FILED Feb. 14, 2015
BAKER COUNTY SURVEYOR
SURVEY NO. 9-40-730