

W 1/2 SEC. 21, T 9 S, R 40 E, W. M.

11  
FND. 'PK' NAIL  
CS 9-40-550  
N 126202.318  
E 2712000.884

1000  
FND. RAILROAD SPIKE, ACCEPT AS  
INTERSECTION OF ELM ST. AND  
INDIANA AVE. CS 9-40-494; 9-40-495;  
DESTROYED DURING CONSTRUCTION,  
REPLACED WITH 16mm x 203mm (5/8" x 8")  
IRON ROD, SET IN CONCRETE, W/ODOT  
ALUM. CAP IN 102mm (4") PIPE CASING  
N 125776.525  
E 2711985.585

BC13  
FND. 16mm (5/8") IRON ROD  
W/PLASTIC CAP IN MONUMENT  
BOX FOR SEC. COR. COMMON TO  
SEC. 17, 16, 20, AND 21,  
CS 9-40-136 BC, 9-40-293  
N 126619.517  
E 2711771.227

(35')  
CS 9-40-494  
CS 9-40-495

0+823.598 PC  
[27+02.1 PC]

(40')  
CS 9-40-494  
CS 9-40-495

R 436.594m  
Δ 48°16'00"  
L 367.792m  
T 195.603m  
[4° C.L.]  
[Δ 48°16']  
[T 641.8']

1+191.390 PT  
[39+08.8 PT]

1+019.201 PI  
N 125572.337  
E 2711983.582

1006  
FOUND RAILROAD SPIKE, ACCEPT  
AS 1+615.391 P.I.; DESTROYED DURING  
CONSTRUCTION. REPLACED WITH  
16mm x 762mm (5/8" x 30") IRON  
ROD W/ODOT ALUM. CAP IN  
102mm (4") PIPE CASING  
N 125155.375  
E 2712441.893

1+581.353 PC  
[51+88.3 PC]

[0°30' C.R.]  
[Δ 1°07']  
[L 111.7']  
R 3492.751m  
Δ 1°07'00"  
L 68.072m  
T 34.038m

1+649.426 PT  
[54+11.6 P.T.]

17/16  
20/21

N0°45'22"E 1623.126m

1005  
FND. BRASS CAP IN  
MON. BOX 0.9m (3 FT)  
DOWN FROM SURFACE  
FOR COR. COMMON TO  
SEC. 20, 21, 29, 28  
CS 9-40-112 BC, 9-40-181  
N 124996.532  
E 2711749.806


20/21  
29/28

LEGEND

- ( ) RECORD DATA AS NOTED
- [ ] OSHD DRG. 3B-22-23
- ▲ RESET MONUMENT
- FOUND MONUMENT AS NOTED
- RETRACED CENTERLINE
- R/W BOUNDARY

REGISTERED  
PROFESSIONAL  
LAND SURVEYOR  
*Robert E. Butler*  
OREGON  
JULY 25, 1995  
ROBERT E. BUTLER  
2733

EXPIRES DECEMBER 31, 2015

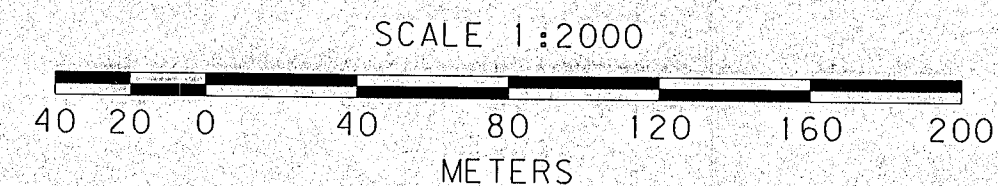

TO CONVERT METERS TO FEET DIVIDE BY 0.3048

OREGON DEPARTMENT OF TRANSPORTATION  
RIGHT-OF-WAY NETWORK MONUMENTATION MAP  
OF THE DEWEY AVENUE (BAKER CITY) SECTION  
OF THE WHITNEY AND LA GRANDE - BAKER CITY HIGHWAYS

MARCH 17, 2004 FOR ODOT REGION 5  
3012 ISLAND AVENUE, LA GRANDE, OREGON, 97850  
RETRACED CENTERLINE, RESET & FOUND MONUMENTS SHEET 4 OF 4

FILED August 10, 2015  
BAKER COUNTY SURVEYOR  
SURVEY NO. 9-40-738