


RECORD OF SURVEY

A TRACT OF LAND SITUATED IN SOUTHEAST QUARTER OF SECTION 17,
TOWNSHIP 9 SOUTH, RANGE 40 EAST OF THE WILLAMETTE MERIDIAN,
CITY OF BAKER CITY, COUNTY OF BAKER, STATE OF OREGON.

DETAIL OF SUBJECT TRACT

DETAIL SCALE 1" = 30'

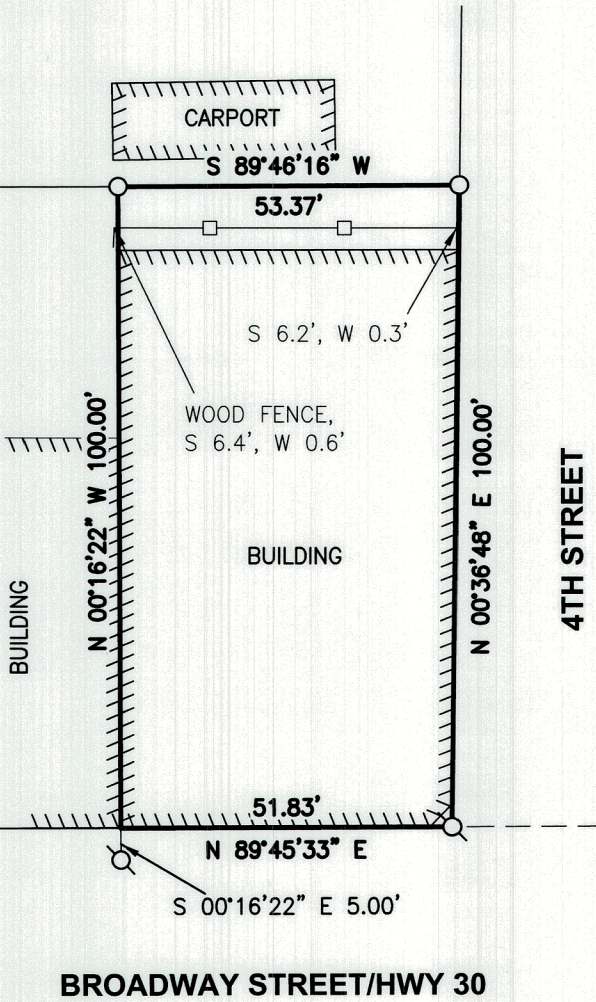

BROADWAY STREET/HWY 30

6TH STREET

4TH STREET

5TH STREET










































































































































