


E.L.N. H.M.A.R.K.
 T9S R40E
 C 1/4 S 20
 2015
 PLS 69494
 LAND SURVEYING

LEGEND

- () RECORD DATA PER REFERENCE LIST ON SHEET 2
- ★ SET GPS CONTROL POINT SEE TABLE ON SHEET 3
- FOUND MONUMENT
- CALCULATED POINT
- RESOLVED RIGHT OF WAY
- EXISTING RIGHT OF WAY OR PROPERTY LINE
- - - SUBDIVISION LOT LINE

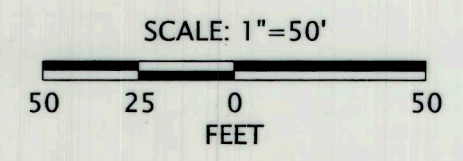

RECOVERED MONUMENT LIST

PT ID	NORTHING	EASTING	STATION	OFFSET	DATE	DESCRIPTION & REFERENCE DOCUMENTS	FD = FOUND MON. = MONUMENT	SN = SURVEY NUMBER YPC = YELLOW PLASTIC CAP
1224	97623.13	131278.44	N/A	N/A	2/25/20	FD 2" DIAMETER IRON PIPE WITH NAIL IN THE CENTER, DOWN 0.5', C.A.E. SMITHS ADDITION		
1225	97764.96	131114.97	N/A	N/A	2/25/20	FD 2" DIAMETER IRON PIPE WITH NAIL IN THE CENTER, DOWN 0.3', C.A.E. SMITHS ADDITION		
1226	97764.97	130813.24	"D"27+31.05	44.80' LT	2/25/20	FD 3/4" DIAMETER IRON PIPE, DOWN 0.5', UNKNOWN ORIGIN		
1227	97472.23	130885.58	N/A	N/A	2/25/20	FD 5/8" IRON ROD WITH YPC MARKED "HANLEY ENGR PLS 1206", DOWN 0.5', SN 09-40-0480		
1228	97432.26	130915.15	N/A	N/A	2/25/20	FD 1" IRON PIPE WITH NAIL IN CENTER, IN MON. BOX, ORIGIN UNKNOWN, FD ON SN 09-40-480		
1229	97559.30	130974.94	N/A	N/A	2/25/20	FD 3/4" IRON ROD IN MONUMENT BOX, ORIGIN UNKNOWN, FD ON SN 09-40-480		
1250	97431.94	129515.83	N/A	N/A	5/12/20	FD 5/8" IRON ROD WITH 2" ALUM. CAP MARKED AS SHOWN, IN MON BOX, SN 09-40-0736		
1265	97570.07	130605.40	"B"553+53.14	38.53' LT	5/21/20	FD 5/8" IRON ROD, UP 0.3', SN 09-40-0243		
1266	97471.62	130543.88	"B"552+39.58	51.79' LT	5/21/20	FD 5/8" IRON ROD, BENT, SPUN FOR POSITION, DOWN 1.2', HILLCREST CIRCLE ADDITION		
1281	96637.86	131638.51	N/A	N/A	5/22/20	FD 5/8" IRON ROD WITH YPC MARKED "HANLEY ENGR PLS 1206", DOWN 0.4', SN 09-40-0466		
1282	97390.70	131175.63	N/A	N/A	5/22/20	FD 5/8" IRON ROD WITH YPC MARKED "HANLEY ENGR PLS 1206", DOWN 0.2', SN 09-40-0466		

APRIL 28, 2021
 BAKER COUNTY SURVEYOR
 SURVEY NO. 9-40-823

REGISTERED PROFESSIONAL LAND SURVEYOR

B. N. Elithorp
 OREGON
 JAN. 14, 2003
 BRET N. ELITHORP
 63148
 EXPIRES: 12-31-2021

OREGON DEPARTMENT OF TRANSPORTATION
 HORIZONTAL CONTROL, RECOVERY AND RETRACEMENT MAP
 BAKER-COPPERFIELD HWY. (OR7)(MAIN ST.): CAMPBELL TO BROADWAY
 LA GRANDE-BAKER HWY. (US30): 10TH TO S. BRIDGE ST.
 WHITNEY HWY. (DEWEY ST.): AUBURN TO INDIANA
 BAKER COUNTY
 ODOT REGION 5 TECH CENTER
 3012 ISLAND AVENUE
 LA GRANDE, OR 97850
 KEY NO. 21494
 APRIL 27, 2021
 SCALE: 1"=50'
 SHEET 12 OF 23