


SEE SHEET 16 OF 23

SEE SHEET 18 OF 23

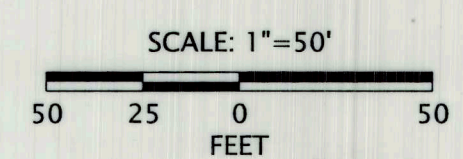

| LEGEND | |
|---|--|
| () RECORD DATA PER REFERENCE LIST ON SHEET 2 | ○ FOUND MONUMENT |
| ★ SET GPS CONTROL POINT SEE TABLE ON SHEET 3 | — RESOLVED RIGHT OF WAY |
| | — EXISTING RIGHT OF WAY OR PROPERTY LINE |
| | - - - SUBDIVISION LOT LINE |

FILED April 28, 2021
 BAKER COUNTY SURVEYOR
 SURVEY NO. 9-40-823

RECOVERED MONUMENT LIST

| PT ID | NORTHING | EASTING | STATION | OFFSET | DATE | DESCRIPTION & REFERENCE DOCUMENTS | ALUM. = ALUMINUM DN = DOWN FD = FOUND | MON. = MONUMENT SN = SURVEY NUMBER W/ = WITH |
|-------|----------|-----------|-------------|----------|---------|---|---|--|
| 1170 | 97334.81 | 132904.06 | "E"26+73.90 | 0.00' RT | 2/25/20 | FD 5/8" IRON ROD W/ 1-1/2" ALUM. CAP, "OREGON DEPT. TRANS.", IN MON. BOX, SN 09-40-0738 | | |
| 1171 | 97791.42 | 133192.33 | N/A | N/A | 2/25/20 | FD 3/4" IRON PIPE IN MON. BOX, DN 0.7', UNKNOWN ORIGIN, FD ON SN 09-40-0135 & AD-21-24 | | |
| 1172 | 97798.00 | 132624.74 | N/A | N/A | 2/25/20 | FD 1/2" IRON ROD IN MON. BOX, DN 0.4', UNKNOWN ORIGIN, FD ON SN 09-40-0135 & AD-21-24 | | |
| 1173 | 98257.95 | 132629.16 | N/A | N/A | 2/25/20 | FD 5/8" IRON ROD IN MON. BOX, DN 0.2', UNKNOWN ORIGIN, FD ON SN 09-40-0094BC & AD-21-24 | | |
| 1174 | 98251.36 | 133197.23 | N/A | N/A | 2/25/20 | FD 1" IRON PIPE IN MON. BOX, DN 0.8', UNKNOWN ORIGIN, FD ON SN 09-40-0094BC & AD-21-24 | | |
| 1277 | 97331.33 | 133187.78 | N/A | N/A | 5/22/20 | FD 1/2" IRON ROD IN MON. BOX, DN 2.0', UNKNOWN ORIGIN, FD ON SN 09-40-0170BC & AD-21-24 | | |
| 1278 | 97338.08 | 132620.01 | N/A | N/A | 5/22/20 | FD 1/2" IRON ROD IN MON. BOX, DN 0.2', UNKNOWN ORIGIN, FD ON SN 09-40-494 & AD-21-24 | | |

REGISTERED PROFESSIONAL LAND SURVEYOR

B. Elithorp
 OREGON
 JAN. 14, 2003
 BRET N. ELITHORP
 63148

EXPIRES: 12-31-2021

OREGON DEPARTMENT OF TRANSPORTATION
 HORIZONTAL CONTROL, RECOVERY AND RETRACEMENT MAP
 BAKER-COPPERFIELD HWY. (OR7)(MAIN ST.) : CAMPBELL TO BROADWAY
 LA GRANDE-BAKER HWY. (US30): 10TH TO S. BRIDGE ST.
 WHITNEY HWY. (DEWEY ST.): AUBURN TO INDIANA
 BAKER COUNTY



ODOT REGION 5 TECH CENTER
 3012 ISLAND AVENUE
 LA GRANDE, OR 97850
 KEY NO. 21494

APRIL 27, 2021
 SCALE: 1"=50'
 SHEET 17 OF 23