


SW 1/4 SECTION 21 T9S R40E WM

"E"  
 0°30'00"C.R.  
 R = 11457.45'  
 Δ = 1°07'00"  
 T = 111.65'  
 (0°30'C.R.X27X33)  
 (Δ = 1°07'X27X33X134X154)  
 (T = 111.7'X27X33)  
 (T = 111.78'X134X154)  
 (R = 11459.16'X134X154)

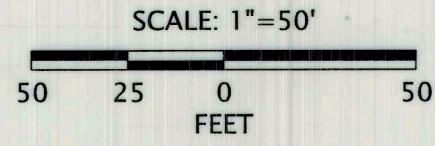

SEE SHEET 19 OF 23

LA GRANDE - BAKER HIGHWAY (OLD US 30)(ELM ST.)

S 47°42'00" E  
 (S 47°50' EX27X33)  
 (S47°42'17" EX134X154)

UNION PACIFIC RAILROAD

"E"52+99.824 P.I.  
 N 95296.808  
 E 134400.964

"E"55+00.000 P.O.T.  
 N 95159.223  
 E 134546.372

S 46°35'00" E

(40.00')  
 (33)

"E"54+11.47 P.I.  
 (54+11.50 P.T.X134X154)  
 (54+11.6 P.T.X27X33)

"E"51+88.17 P.C.  
 (51+88.16 P.C.X154)  
 (51+88.3 P.C.X27X33)

"RR"4229+49.61

"RR"4225+00

"E"45+00

"E"50+00

R488

LEGEND	
( )	RECORD DATA PER REFERENCE LIST ON SHEET 2
★	SET GPS CONTROL POINT SEE TABLE ON SHEET 3
○	FOUND MONUMENT
⊕	FOUND BENCHMARK, SEE TABLE ON SHEET 3
—	EXISTING RIGHT OF WAY OR PROPERTY LINE
- - -	SUBDIVISION LOT LINE

RECOVERED MONUMENT LIST

PT ID	NORTHING	EASTING	STATION	OFFSET	DATE	DESCRIPTION & REFERENCE DOCUMENTS
1279	95296.81	134400.96	"E"52+99.82	0.54' LT	5/22/20	FD 5/8" IRON ROD W/ 1-1/2" ALUM. CAP, "OREGON DEPT. TRANS.", IN MON. BOX, SN 09-40-0738

ALUM. = ALUMINUM  
 FD = FOUND  
 MON. = MONUMENT  
 SN = SURVEY NUMBER  
 W/ = WITH

REGISTERED PROFESSIONAL LAND SURVEYOR

*BEE*

OREGON  
 JAN. 14, 2003  
 BRET N. ELITHORP  
 63148

EXPIRES: 12-31-2021

FILED April 28, 2021  
 BAKER COUNTY SURVEYOR  
 SURVEY NO. 9-40-823

OREGON DEPARTMENT OF TRANSPORTATION

HORIZONTAL CONTROL, RECOVERY AND RETRACEMENT MAP  
 BAKER-COPPERFIELD HWY. (OR7)(MAIN ST.): CAMPBELL TO BROADWAY  
 LA GRANDE-BAKER HWY. (US30): 10TH TO S. BRIDGE ST.  
 WHITNEY HWY. (DEWEY ST.): AUBURN TO INDIANA  
 BAKER COUNTY

ODOT REGION 5 TECH CENTER  
 3012 ISLAND AVENUE  
 LA GRANDE, OR 97850  
 KEY NO. 21494

APRIL 27, 2021  
 SCALE: 1"=50'  
 SHEET 20 OF 23