


SE 1/4 SECTION 17 T9S R40E WM

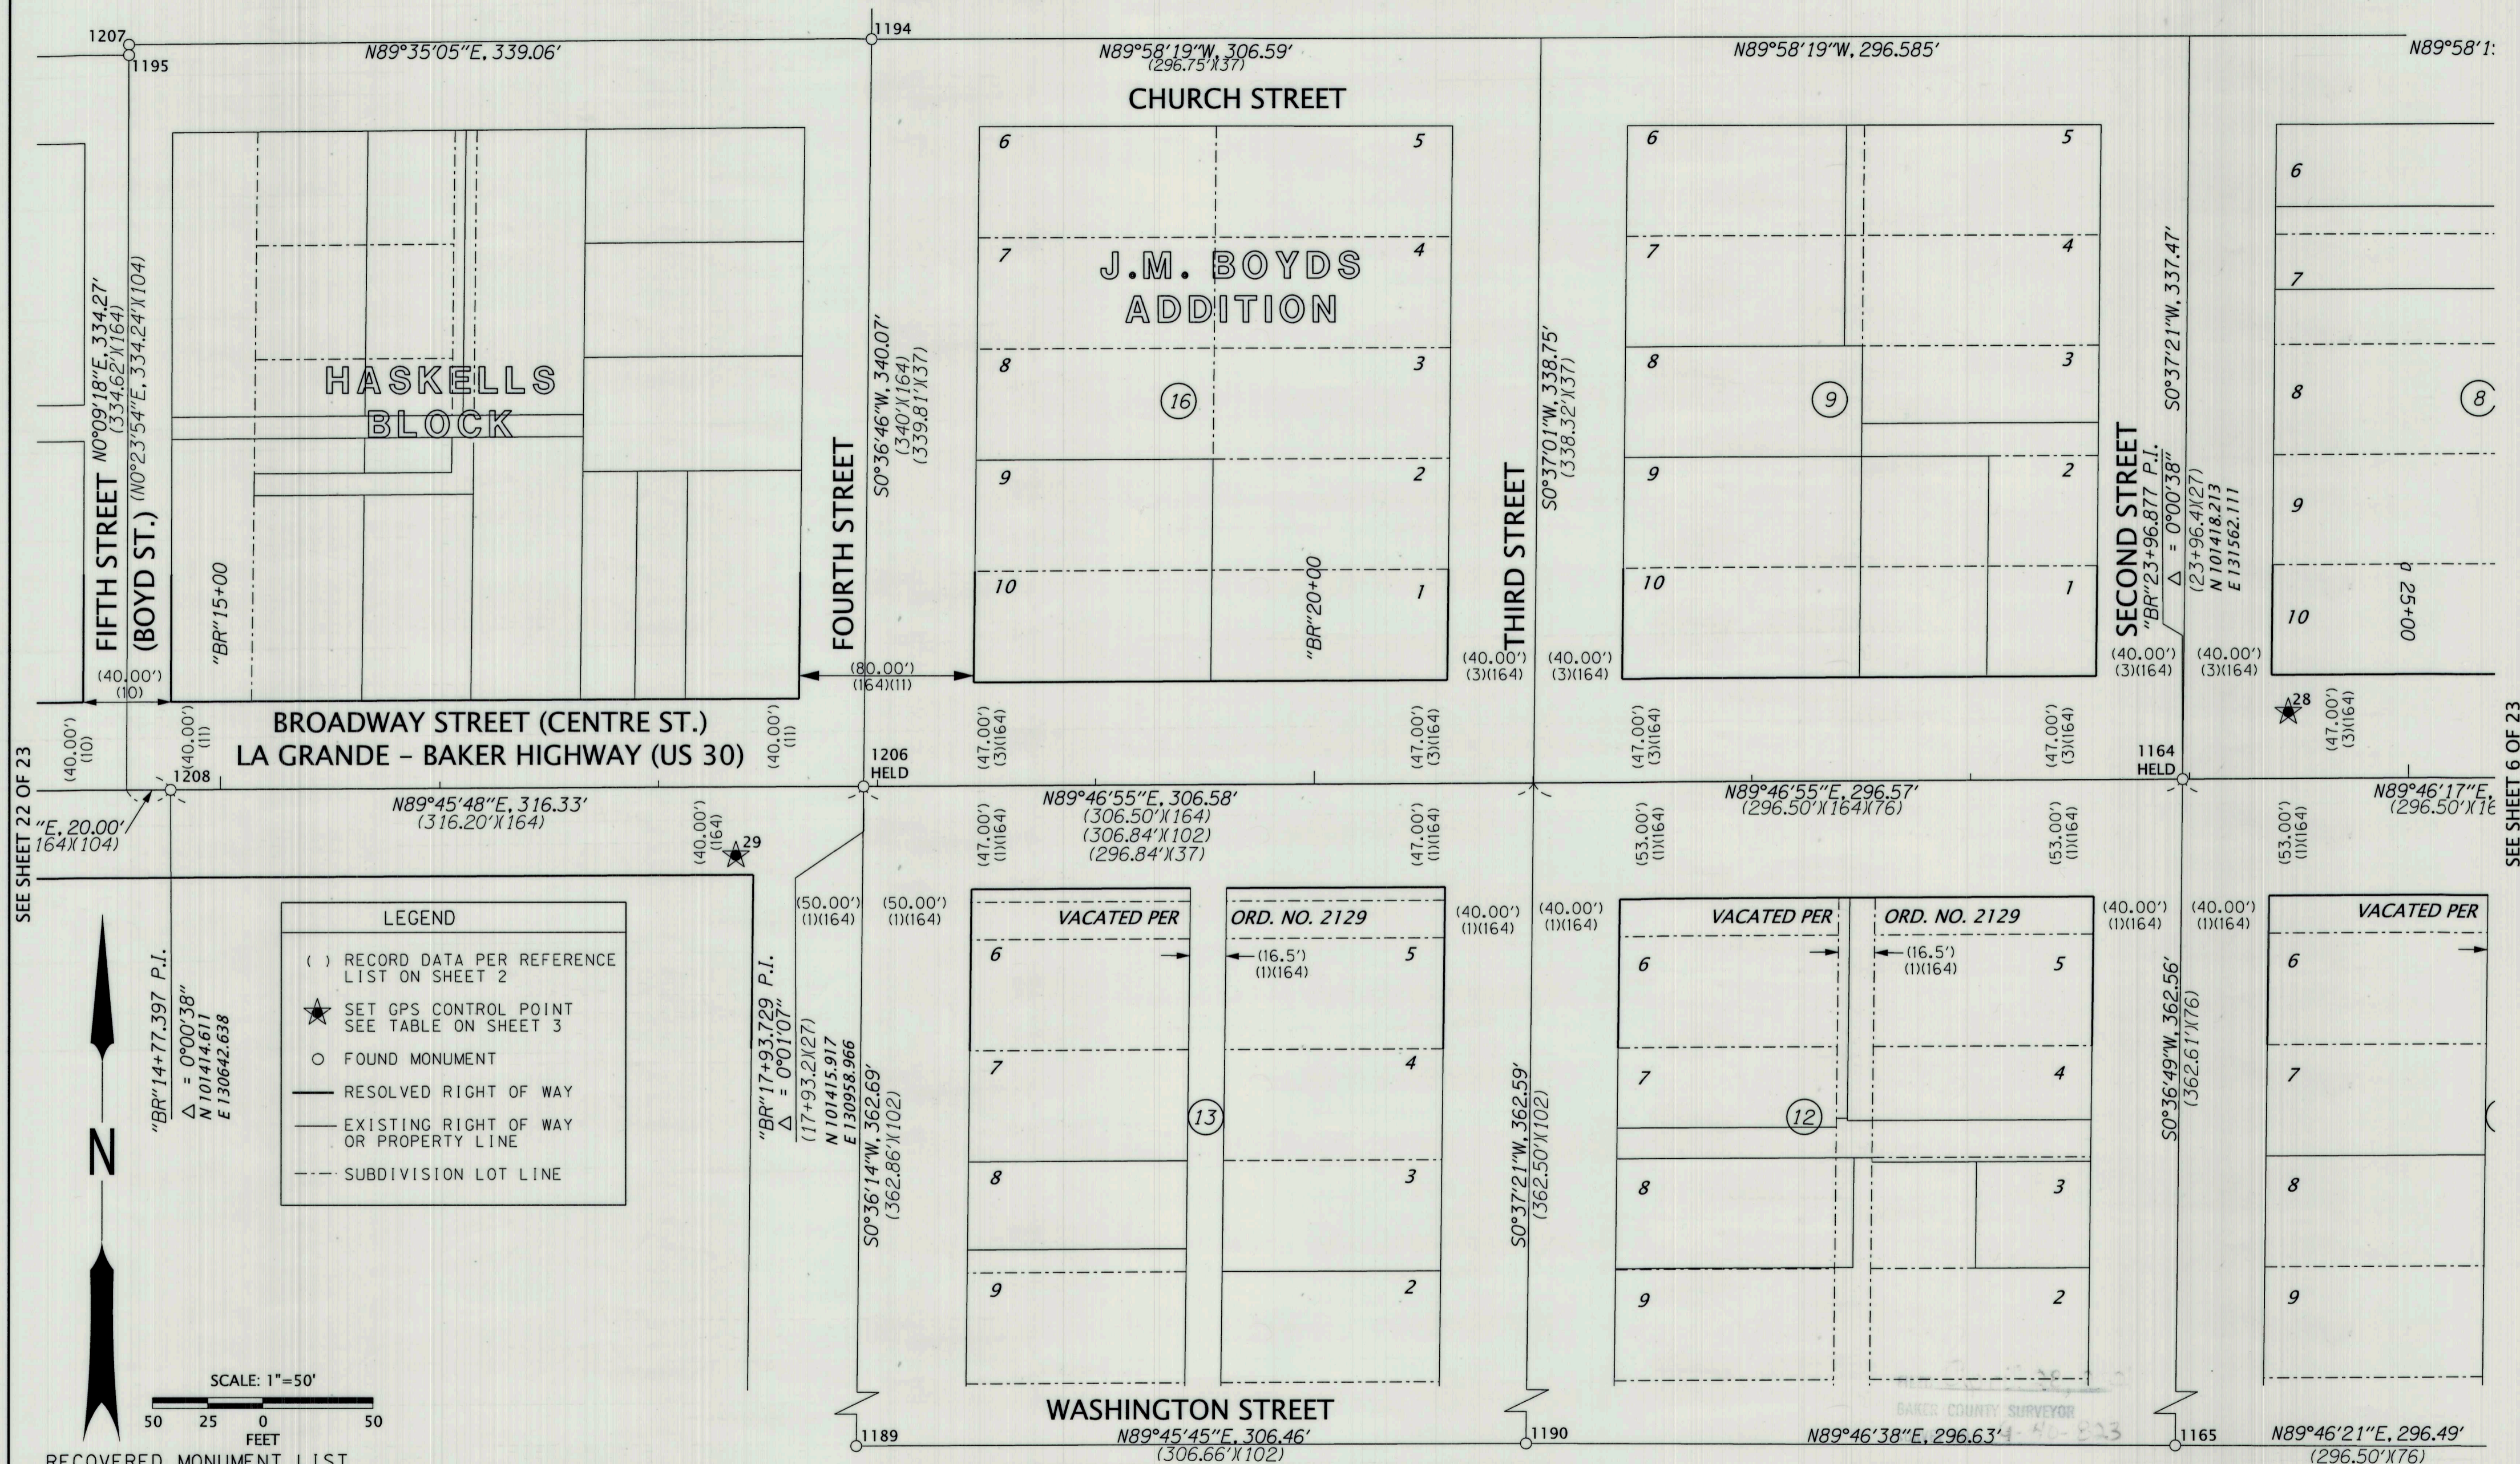


SEE SHEET 22 OF 23

SEE SHEET 6 OF 23

LEGEND

- () RECORD DATA PER REFERENCE LIST ON SHEET 2
- ★ SET GPS CONTROL POINT SEE TABLE ON SHEET 3
- FOUND MONUMENT
- RESOLVED RIGHT OF WAY
- - - EXISTING RIGHT OF WAY OR PROPERTY LINE
- - - SUBDIVISION LOT LINE

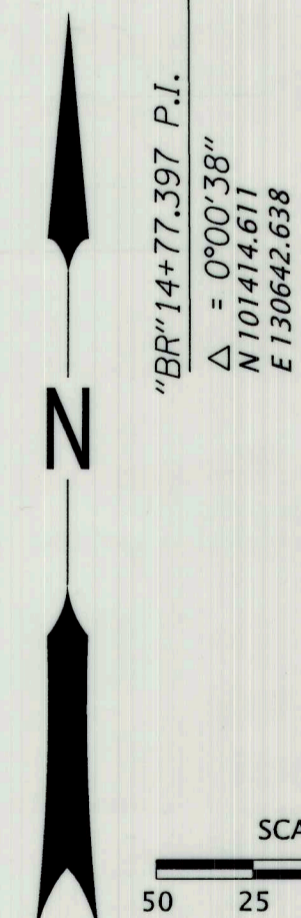

RECOVERED MONUMENT LIST

PT ID	NORTHING	EASTING	STATION	OFFSET	DATE	DESCRIPTION & REFERENCE DOCUMENTS	ALUM. = ALUMINUM DN= DOWN FD = FOUND	MON. = MONUMENT SN = SURVEY NUMBER W/ = WITH
1164	101418.21	131562.11	"BR"23+96.88	0.00' RT	2/25/20	FD 5/8" IRON ROD WITH YPC MARKED "CITY OF BAKER PLS 2162", IN MON. BOX, SN 09-40-0272		
1165	101055.67	131558.23	N/A	N/A	2/25/20	FD 1/2" IRON ROD IN MON. BOX, DN 0.8', UNKNOWN ORIGIN, FD ON SN 09-40-0123		
1189	101053.25	130955.14	N/A	N/A	2/25/20	FD 5/8" IRON ROD IN MON. BOX, DN 0.2', UNKNOWN ORIGIN, FD ON SN 09-40-0260 & AD-20-13		
1190	101054.52	131261.60	N/A	N/A	2/25/20	FD 1" IRON PIPE W/ 1-1/4" CAP, IN MON. BOX, DN 0.4', UNKNOWN ORIGIN, NO RECORD FOUND		
1194	101755.96	130962.60	N/A	N/A	2/25/20	FD 3/4" IRON ROD IN MON. BOX, DN 0.7', UNKNOWN ORIGIN, FD ON SN 09-40-0224		
1195	101748.79	130623.53	N/A	N/A	2/25/20	FD 1-1/4" IRON PIPE W/ 1-1/4" CAP IN MON. BOX, DN 0.5', UNKNOWN ORIGIN, FD ON SN 09-40-0285		
1206	101415.92	130958.97	"BR"17+93.73	0.00' RT	2/25/20	FD 5/8" IRON ROD WITH YPC MARKED "CITY OF BAKER PLS 2162", IN MON. BOX, SN 09-40-0272		
1207	101753.51	130623.56	N/A	N/A	2/25/20	FD 3/4" IRON ROD IN MON. BOX, DN 0.4', UNKNOWN ORIGIN		
1208	101414.61	130642.64	"BR"14+77.40	0.00' RT	2/26/20	FD 5/8" IRON ROD WITH YPC MARKED "CITY OF BAKER PLS 2162", IN MON. BOX, SN 09-40-0272		

REGISTERED PROFESSIONAL LAND SURVEYOR

B. N. Elithorp

OREGON
JAN. 14, 2003
BRET N. ELITHORP
63148

EXPIRES: 12-31-2021

OREGON DEPARTMENT OF TRANSPORTATION

HORIZONTAL CONTROL, RECOVERY AND RETRACEMENT MAP
BAKER-COPPERFIELD HWY. (OR7)(MAIN ST.) : CAMPBELL TO BROADWAY
LA GRANDE-BAKER HWY. (US30): 10TH TO S. BRIDGE ST.
WHITNEY HWY. (DEWEY ST.): AUBURN TO INDIANA

BAKER COUNTY

ODOT REGION 5 TECH CENTER
3012 ISLAND AVENUE
LA GRANDE, OR 97850
KEY NO. 21494

FILED April 28, 2021
BAKER COUNTY SURVEYOR
SURVEY NO. 9-40-823
APRIL 27, 2021
SCALE: 1"=50'
SHEET 21 OF 23