


SE 1/4 SECTION 17 T9S R40E WM SW 1/4 SECTION 17 T9S R40E WM

SEE SHEET 22 OF 23

LEGEND	
( )	RECORD DATA PER REFERENCE LIST ON SHEET 2
★	SET GPS CONTROL POINT SEE TABLE ON SHEET 3
○	FOUND MONUMENT
—	RESOLVED RIGHT OF WAY
—	EXISTING RIGHT OF WAY OR PROPERTY LINE
- - -	SUBDIVISION LOT LINE
- - -	RAILROAD RIGHT OF WAY

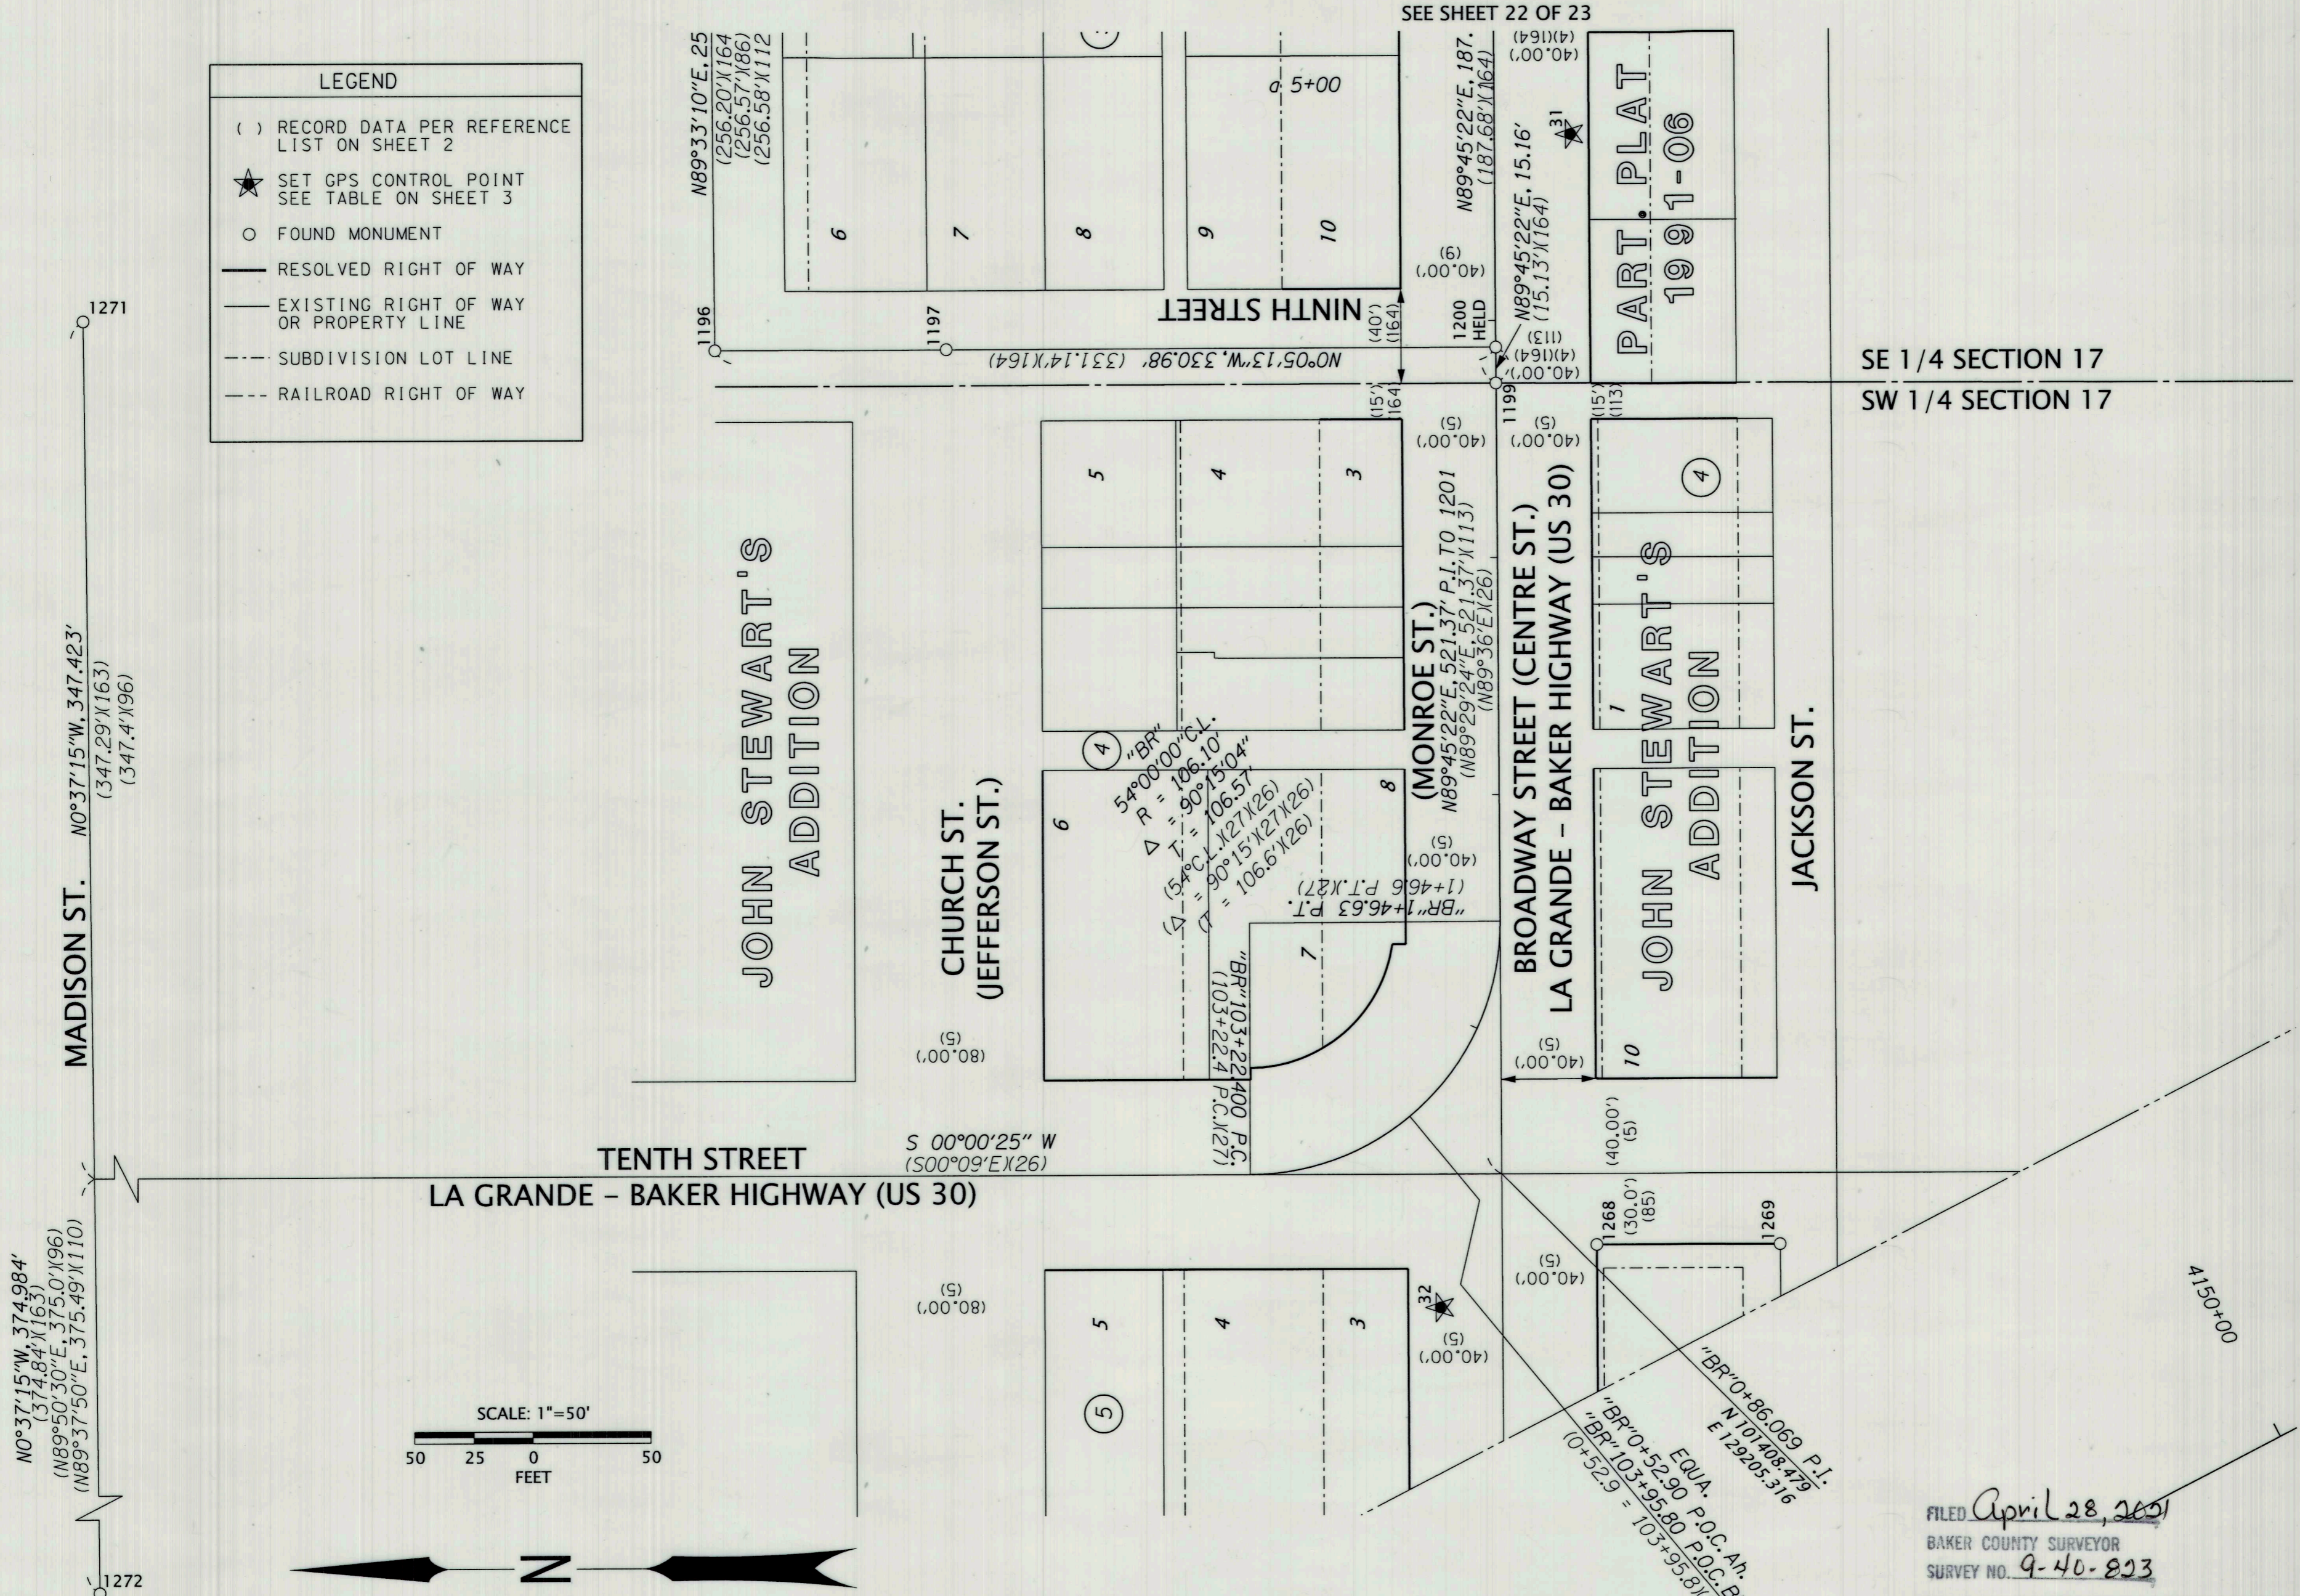

MADISON ST.  $N0^{\circ}37'15''W, 347.423'$   
 (347.29' X 163)  
 (347.4' X 96)

$N0^{\circ}37'15''W, 374.984'$   
 (374.84' X 163)  
 (N89°50'30"E, 375.0' X 96)  
 (N89°37'50"E, 375.49' X 110)

SCALE: 1"=50'  
 50 25 0 25 50  
 FEET

RECOVERED MONUMENT LIST

PT ID	NORTHING	EASTING	STATION	OFFSET	DATE	DESCRIPTION & REFERENCE DOCUMENTS	ALUM. = ALUMINUM FD = FOUND MON. = MONUMENT	SN = SURVEY NUMBER W/ = WITH YPC = YELLOW PLASTIC CAP
1196	101740.94	129553.55	N/A	N/A	2/25/20	FD 3/4" IRON ROD IN MON. BOX, UNKNOWN ORIGIN, FD ON SN 09-40-0160		
1197	101642.89	129553.85	N/A	N/A	2/25/20	FD 3/4" IRON ROD IN MON. BOX, SN 09-40-0017BC		
1199	101409.98	129538.89	"BR"3+73.64	0.08' LT	2/25/20	FD 5/8" IRON ROD W/ YPC, ILLEGIBLE, IN MON. BOX, SN 09-40-0272		
1200	101409.96	129554.05	"BR"3+88.80	0.00' RT	2/25/20	FD 5/8" IRON ROD W/ YPC MARKED "CITY OF BAKER PLS 2162", SN 09-40-0272		
1268	101368.37	129175.31	N/A	N/A	5/21/20	FD 5/8" IRON ROD, FLUSH, SN 09-40-0159		
1269	101290.70	129175.34	N/A	N/A	5/21/20	FD 5/8" IRON ROD, BENT, SPUN FOR POSITION, SN 09-40-0159		
1271	102399.24	129552.84	N/A	N/A	5/22/20	FD 5/8" IRON ROD IN MON. BOX, DN 0.3', UNKNOWN ORIGIN, FD ON SN 09-40-0217		
1272	102391.41	128830.47	N/A	N/A	5/22/20	FD RAILROAD SPIKE IN MON. BOX, DN 1.7', UNKNOWN ORIGIN, FD ON SN 09-40-0217		

REGISTERED PROFESSIONAL LAND SURVEYOR

OREGON  
 JAN. 14, 2003  
 BRET N. ELITHORP  
 63148

EXPIRES: 12-31-2021

FILED April 28, 2021  
 BAKER COUNTY SURVEYOR  
 SURVEY NO. 9-40-823

**OREGON DEPARTMENT OF TRANSPORTATION**

HORIZONTAL CONTROL, RECOVERY AND RETRACEMENT MAP  
 BAKER-COPPERFIELD HWY. (OR7)(MAIN ST.) : CAMPBELL TO BROADWAY  
 LA GRANDE-BAKER HWY. (US30): 10TH TO S. BRIDGE ST.  
 WHITNEY HWY. (DEWEY ST.): AUBURN TO INDIANA  
 BAKER COUNTY

ODOT REGION 5 TECH CENTER  
 3012 ISLAND AVENUE  
 LA GRANDE, OR 97850  
 KEY NO. 21494

APRIL 27, 2021  
 SCALE: 1"=50'  
 SHEET 23 OF 23