

SE 1/4 SECTION 17 T9S R40E WM
SW 1/4 SECTION 16 T9S R40E WM

N89°46'21"E, 296.49'
(296.50'X76)

1167

FIRST STREET

N0°36'45"E, 332.56'
(332.59'X147)

1168

N0°36'45"E, 332.66'
(332.60'X181)

1133

WASHINGTON STREET
(306.58'X147)

6

7

8

9

10

5

4

3

2

1

N89°46'55"E, 306.67'
(306.46'X181X147)

COURT AVE.

U.S. TOWNSITE
OF BAKER

6

7

8

9

10

5

4

3

2

1

N89°45'54"E, 306.66'
(S89°46'05"W, 306.73'X148)
(306.38'X181)

SEE SHEET 6 OF 23

SEE SHEET 8 OF 23

S0°36'54"W, 0.74'
(0.74'X39X58X142)

(40.00')

(1)

(40.00')

(1)

(40.00')

(40.00')

(1)

(40.00')

(1)

(40.00')

(1)

(40.00')

(1)

(40.00')

(1)

(40.00')

(1)

N0°36'54"W, 332.565'
(332.50'X164X144)

(40.00')

(1)

(40.00')

(40.00')

(1)

(40.00')

(1)

(40.00')

(1)

(40.00')

(1)

(40.00')

(1)

(40.00')

(1)

VAR.

12

S

VAR.

S

VAR.

VAR.

VAR.

S

VAR.

S

VAR.

VAR.

VAR.

VAR.

VAR.

S89°18'05"E, 192.29'

(N89°53'06"W, 192.32'X142)
(192.21'X58) (192.50'X39)

(40.00')

(2)

(40.00')

(2)

(40.00')

(2)

(40.00')

(40.00')

(2)

(40.00')

(2)

(40.00')

(2)

(40.00')

(2)

(40.00')

(2)

(40.00')

(2)

(40.00')

(2)

(40.00')

(2)

WASHINGTON STREET

WASHINGTON STREET

S0°36'43"W, 332.37'
(332.37'X139)

(40.00')

(1)

(40.00')

(40.00')

(1)

(40.00')

(1)

(40.00')

(1)

(40.00')

(1)

(40.00')

(1)

(40.00')

(1)

(40.00')

(1)

(40.00')

(1)

(40.00')

(1)

(40.00')

(1)







































































































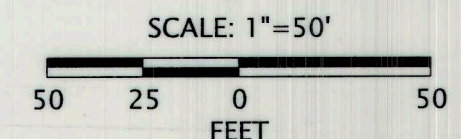

LEGEND	
()	RECORD DATA PER REFERENCE LIST ON SHEET 2
★	SET GPS CONTROL POINT SEE TABLE ON SHEET 3
○	FOUND MONUMENT
—	RESOLVED RIGHT OF WAY
—	EXISTING RIGHT OF WAY OR PROPERTY LINE
- - -	SUBDIVISION LOT LINE

FILED April 28, 2021
BAKER COUNTY SURVEYOR
SURVEY NO. 9-40-823

RECOVERED MONUMENT LIST

PT ID	NORTHING	EASTING	STATION	OFFSET	DATE	DESCRIPTION & REFERENCE DOCUMENTS
1127	101017.73	132395.19	N/A	N/A	2/13/20	FD 5/8" IRON ROD W/ 1-1/2" ALUM. CAP MARKED "APA OR2849 WA41295", FLUSH, SN 09-40-0717
1128	101058.02	132161.40	"M"33+62.60	0.00' RT	2/13/20	FD 5/8" IRON ROD W/ YPC MARKED "CITY OF BAKER PLS 2162", IN MON. BOX, SN 09-40-0272
1129	100403.68	132346.70	N/A	N/A</		